


RECEIVED
APR 18 1973

STATE ENGINEER
SALEM, OREGON

T.6S.R.7W.W.M.

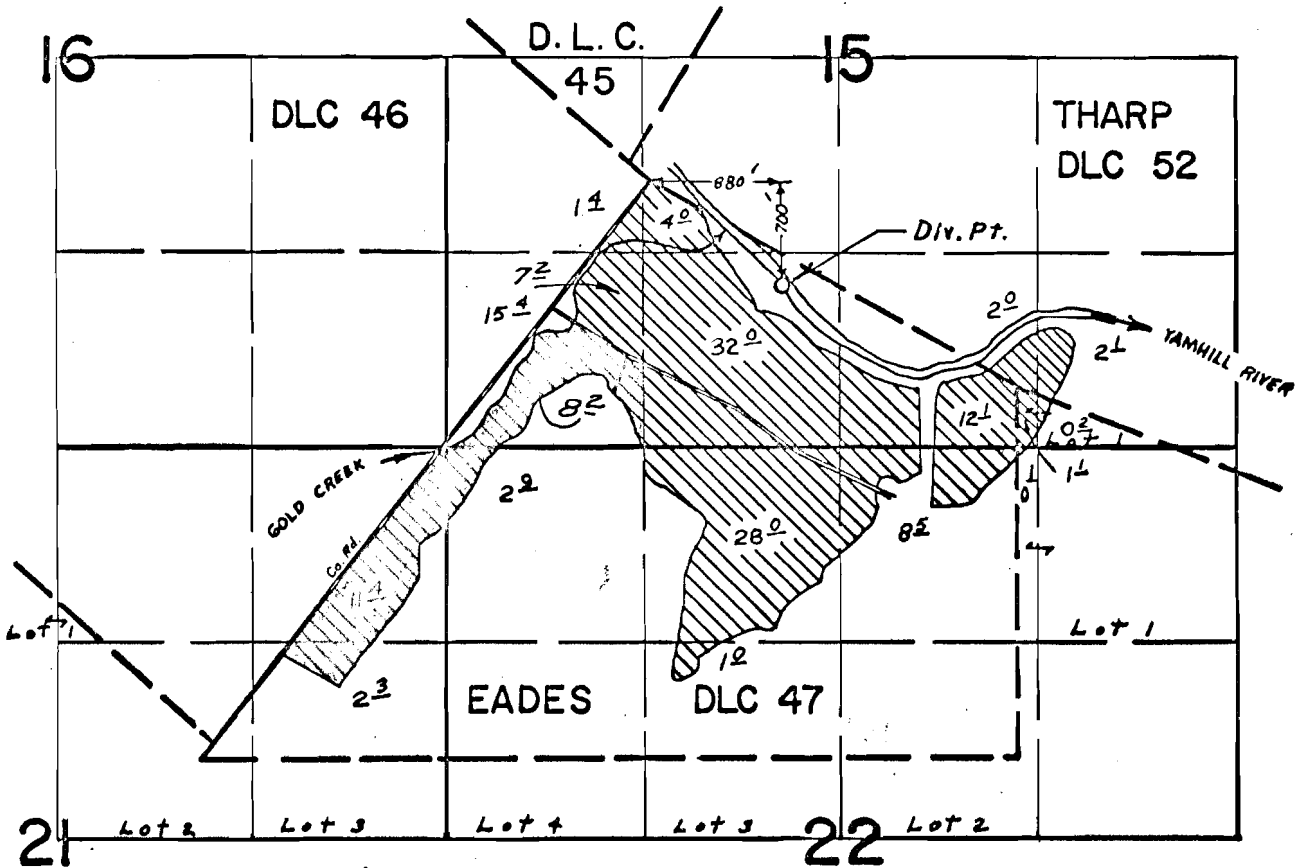

 NEW APPLICATION

FINAL PROOF SURVEY
UNDER

Application No. 44848 Permit No. 33488
IN NAME OF

JOHN E. & JEAN N. THOMPSON

Surveyed SEPT 28 1972, by L. GOULD

Application No. 50305
Permit No. 37983