


T.7S.R3W.W.M.

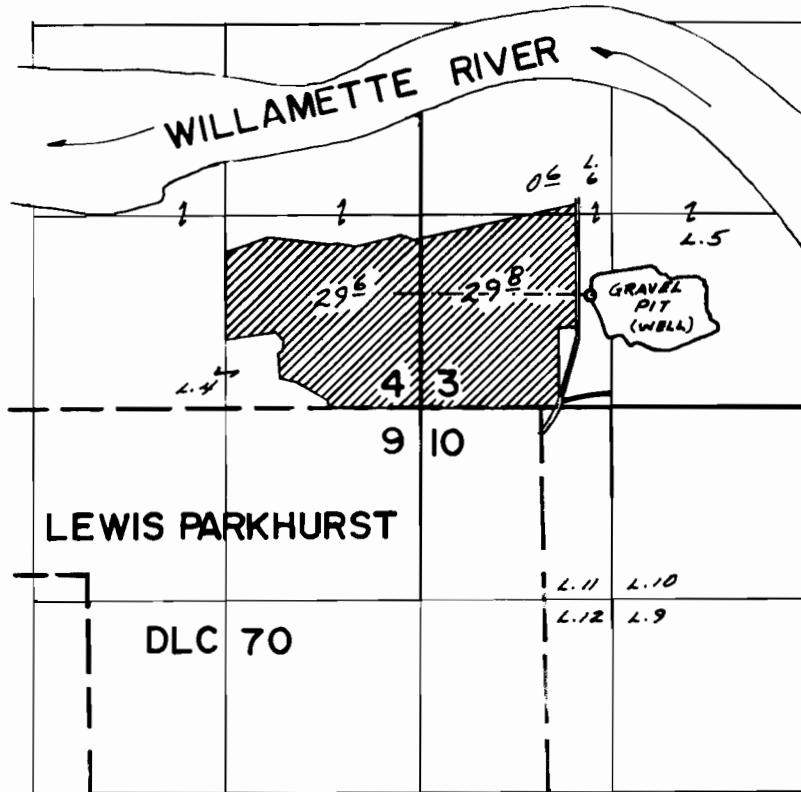

Pit Wall Loc. - 750' N & 350' E From N.E. Cor. PARKHURST DLC 70

FINAL PROOF SURVEY
UNDER

Application No. G-1019... Permit No. G-900...
IN NAME OF

LEONARD KINKAID

Surveyed JUNE 24 1960, by C.O. BARTELS.