


T. 1 & 2 S. R. 9 W. W.M.

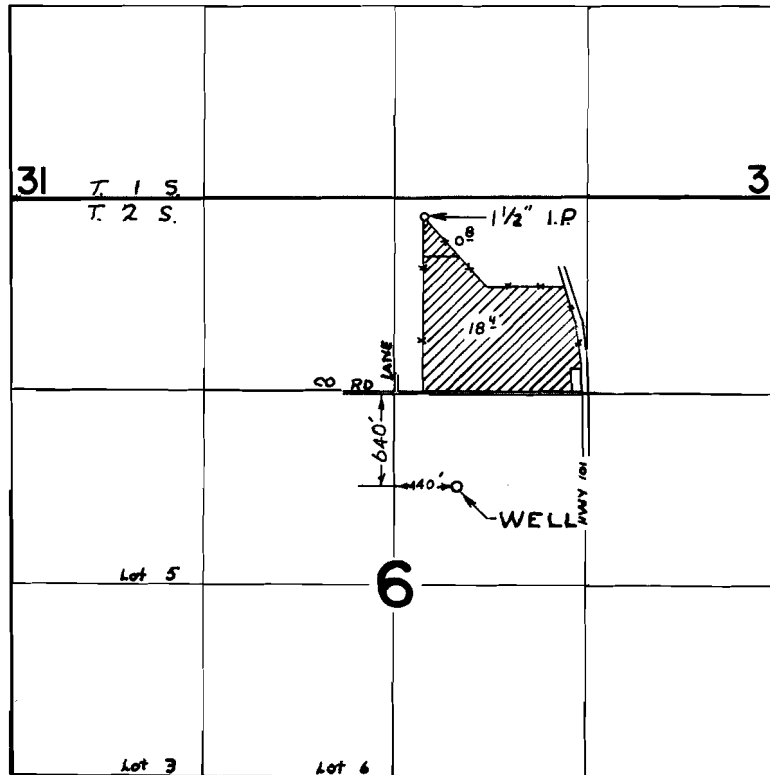

FINAL PROOF SURVEY UNDER

G-5784 G-5555
Application No. G-4259 Permit No. G-4013
IN NAME OF

KENNETH M. JENCK

Surveyed AUG. 6, 1971, by R. MUCKEN
JUNE 28, 1976 L. TOLL