


T4S. RIOW. WM.

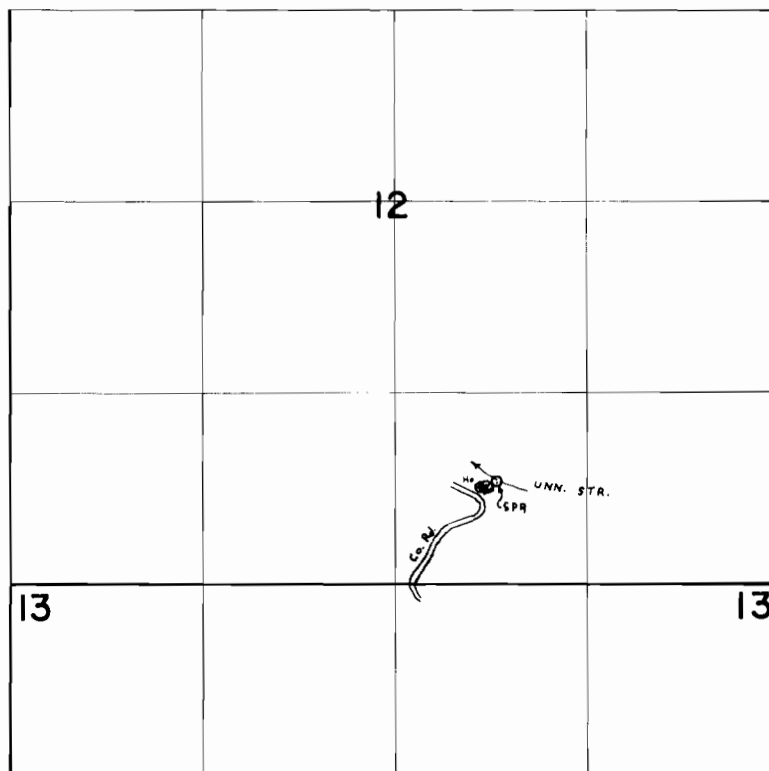

SPRING LOC: 690' N & 700' E from S. 1/4 SEC 12.

FINAL PROOF SURVEY
UNDER

Application No. 43168 Permit No. 32269
IN NAME OF

JAMES J. & BERTHA A. NELSON

Surveyed SEPT 14 1978, by C. L. HUGHES