


T. 3S. R. 9W. W.M.

SEC. 19

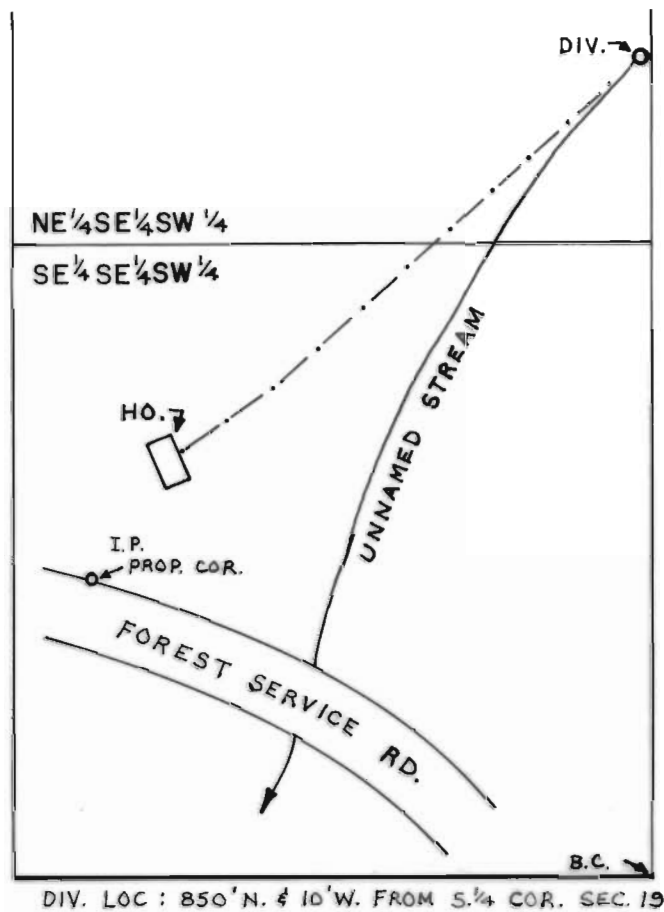

SCALE : 1" = 200'

FINAL PROOF SURVEY
UNDER

Application No. 52698 Permit No. 39829
IN NAME OF

LYLE A. POWERS

Surveyed July 28 1976 by B.G. Mucken