


T.3N.,R.33E.,W.M.

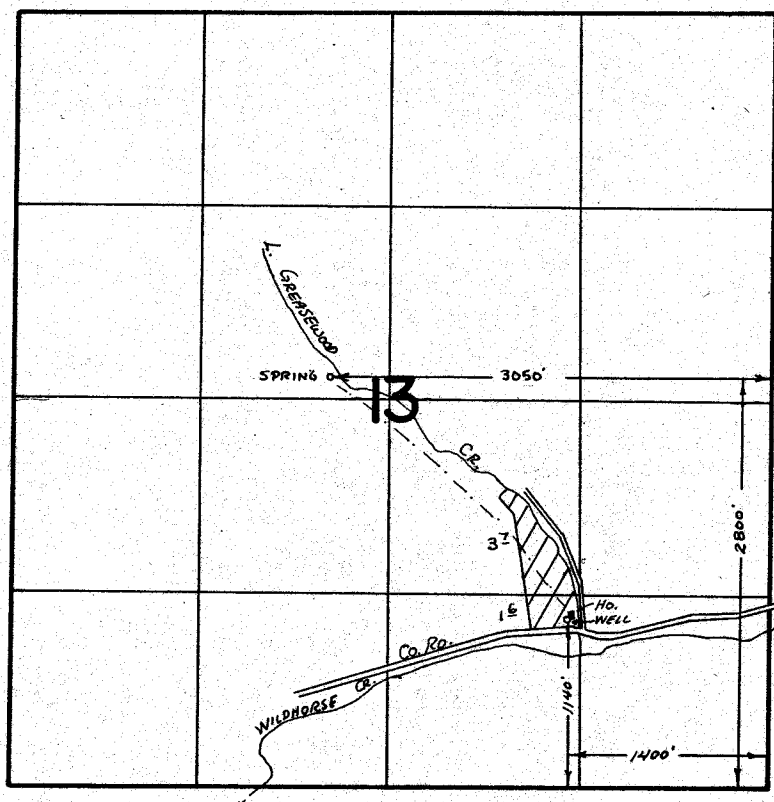

FINAL PROOF SURVEY UNDER

G-4593 G-4319
 Application No. 45375 Permit No. 33877...
 IN NAME OF

ESTATE OF ELDON WITHERS

Surveyed April 14, 1976, by L. T. ...