


G-5592  
47095

T.2N.,R.33E.,W.M.

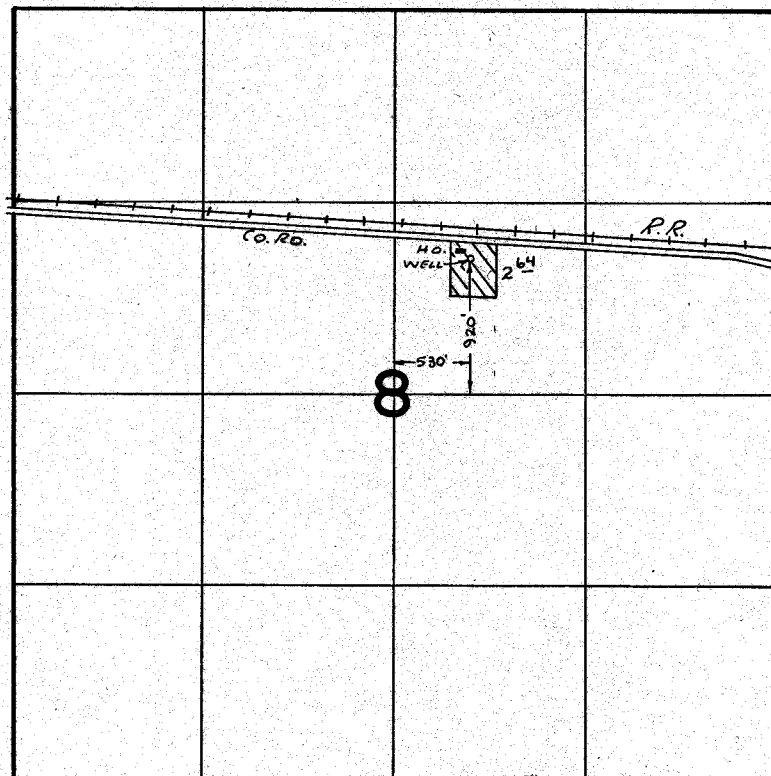

**FINAL PROOF SURVEY**  
UNDER

Application No. G-5854. Permit No. G-5592.  
IN NAME OF

KENNETH W. LARSEN

Surveyed APRIL 10 1976, by L. TOLL