


# T. 4 N., R. 29 E., W.M.

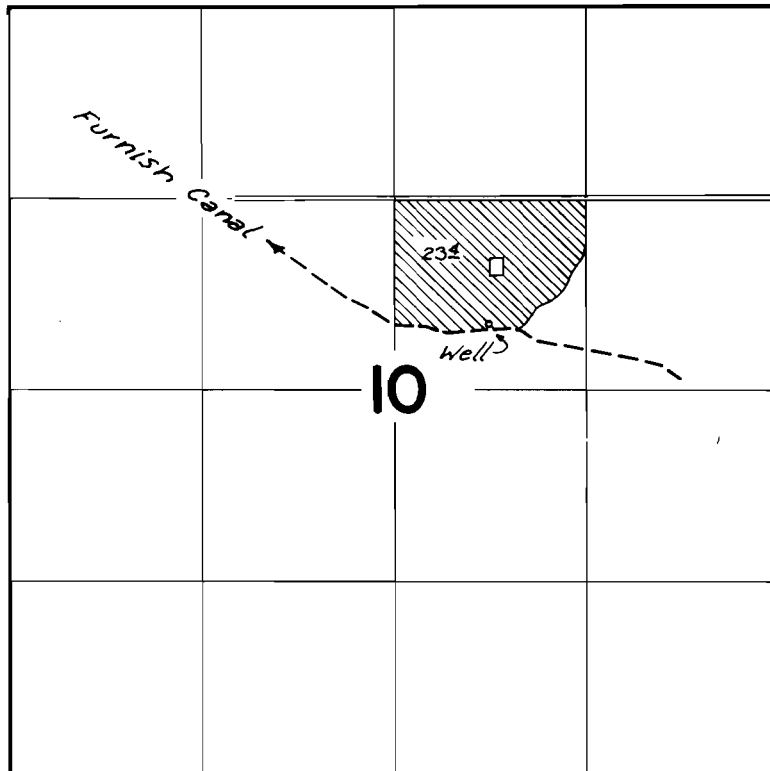

Well Loc.: 470 ft. N. & 660 ft. E. from the Ctr. Sec. 10

## FINAL PROOF SURVEY UNDER

Application No. G-6648 Permit No. G-6209  
IN NAME OF

Randolph Theodore Iszler

Surveyed July 25, 1976, by L. H. Nunn

NZ-3MM-172 *ALB*