


T.3N.,R.33E.,W.M.

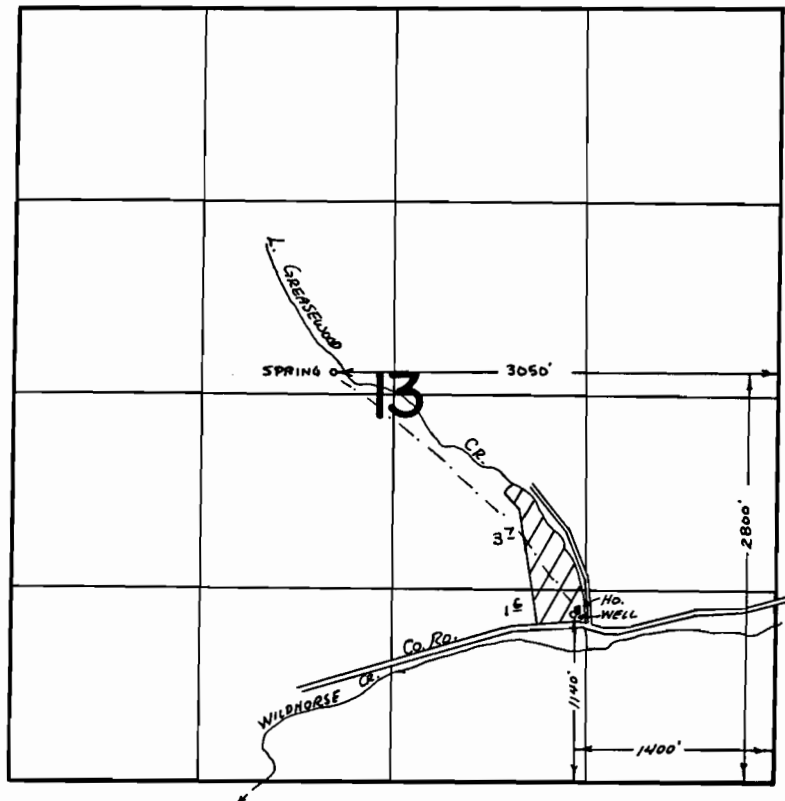

FINAL PROOF SURVEY
UNDER

G-4593 G-4319
Application No. 45375... Permit No. 33877...
IN NAME OF

ESTATE OF ELDON WITHERS

Surveyed APRIL 14, 1976, by L. TOLL