


T. 1 S., R. 39 E., W.M.

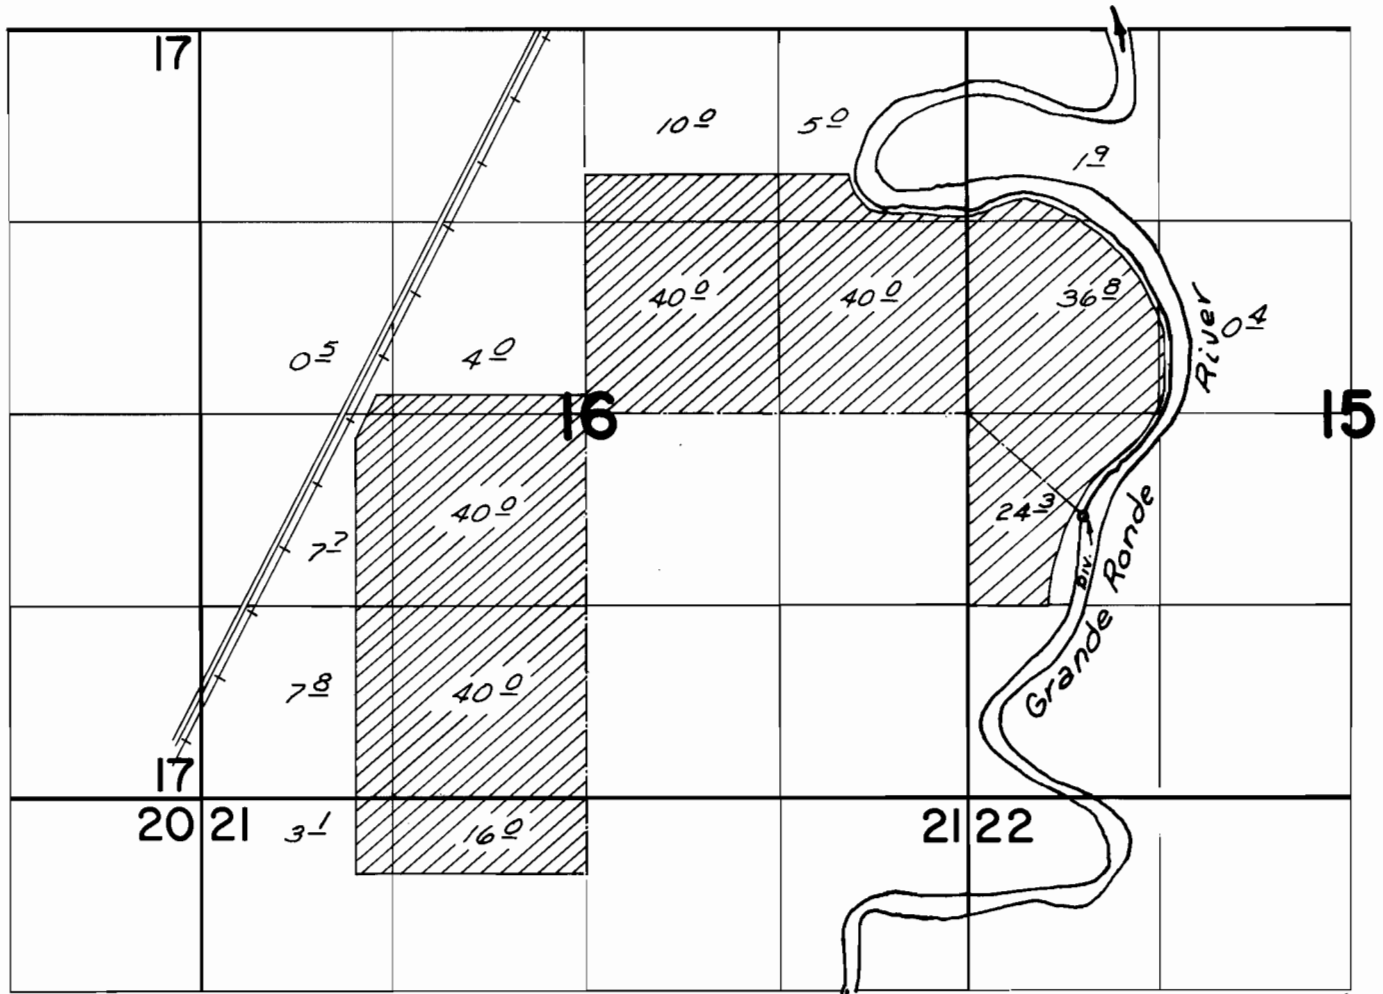

Div. Pt. Loc.: 700 A.S., & 800 A.E. from W 1/4 Cor. Sec. 15

FINAL PROOF SURVEY UNDER

Application No. 39/88 Permit No. 29222
IN NAME OF

Elva Zurbrick

Surveyed Oct 25, 1976 by L.H. Nunn