


T.1S., R.39&40E., W.M.

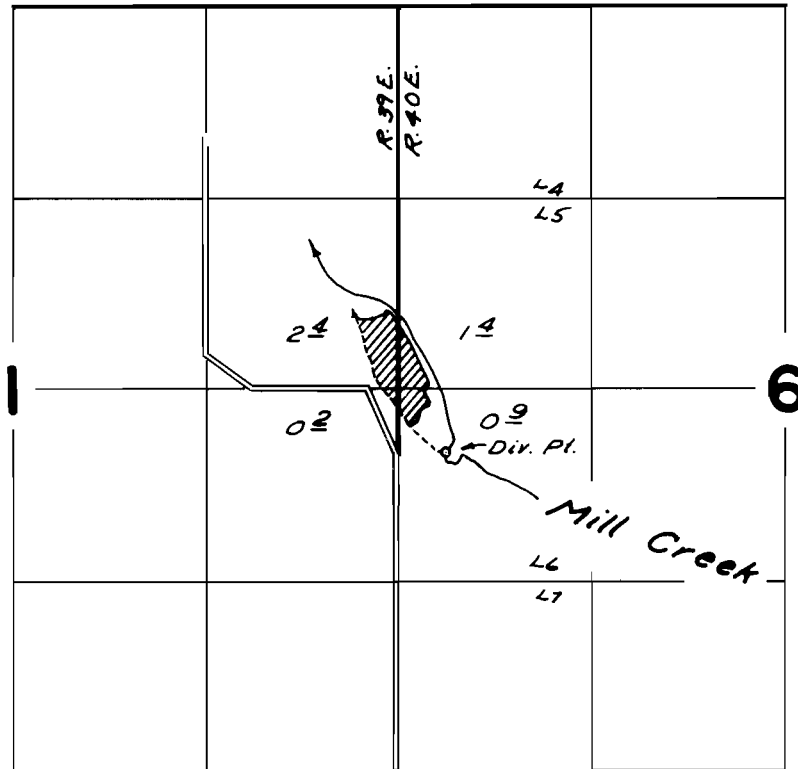

Div. Pt. Loc.: 440 ft. S. & 330 ft. E. from W 1/4 Cor. Sec. 6

FINAL PROOF SURVEY
UNDER

Application No. 50698 Permit No. 38295
IN NAME OF

Fred Roulet

Surveyed Oct. 27, 1976, by L.H. Nunn

AIH-1MM-24 *dB*