


T. 1 N., R. 38 E., W. M.

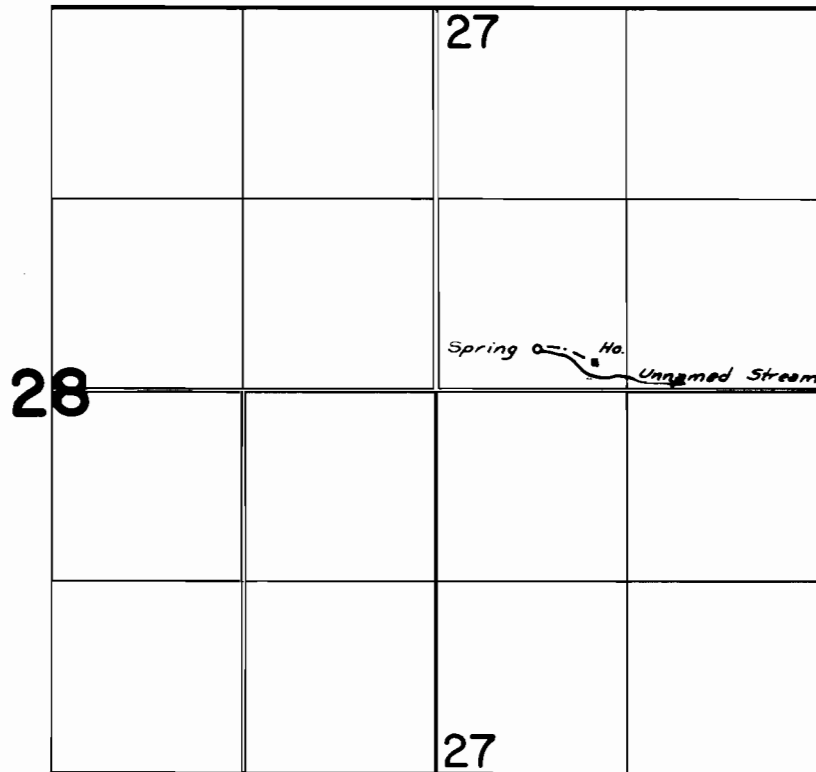

Spring Loc.: 280 ft. N. & 700 ft. E.;  
Div. Pt. Loc.: 70 ft. N. & 1060 ft. E.; both from W. 1/4 Cor. Sec. 27

**FINAL PROOF SURVEY**  
UNDER

Application No. 52623 Permit No. 39671  
IN NAME OF

Ada Craig

Surveyed Oct 27, 1976 by L.H. Nunn