T. 2 S. R. 44 E. W. M.

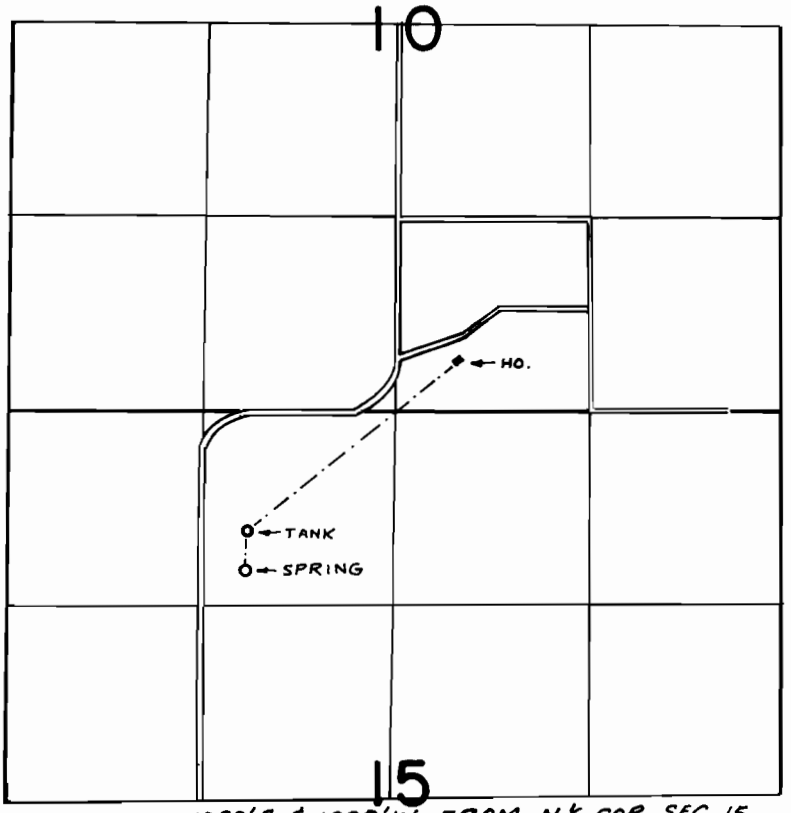

SPRING LOC: 1080'S. & 1000'W. FROM N¼ COR. SEC. 15

FINAL PROOF SURVEY
UNDER

Application No. 51542 Permit No. 38888
IN NAME OF

C. G. & REATHA McCORMACK

Surveyed SEPT. 23, 1976., by R. MUCKEN

BBA-2MM-283