


T.I.S.R. I2E.W.M.

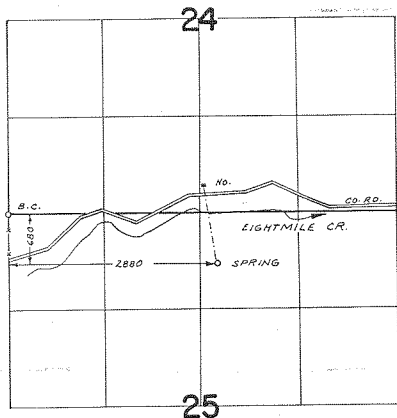

FINAL PROOF SURVEY
UNDER

Application No. *51936* ... Permit No. *39071* ...
IN NAME OF

S. W. SOREINSON

Surveyed *APR. 6, 1976*, by *P. MUCKEN*