


T.1N.R.4W.W.M.

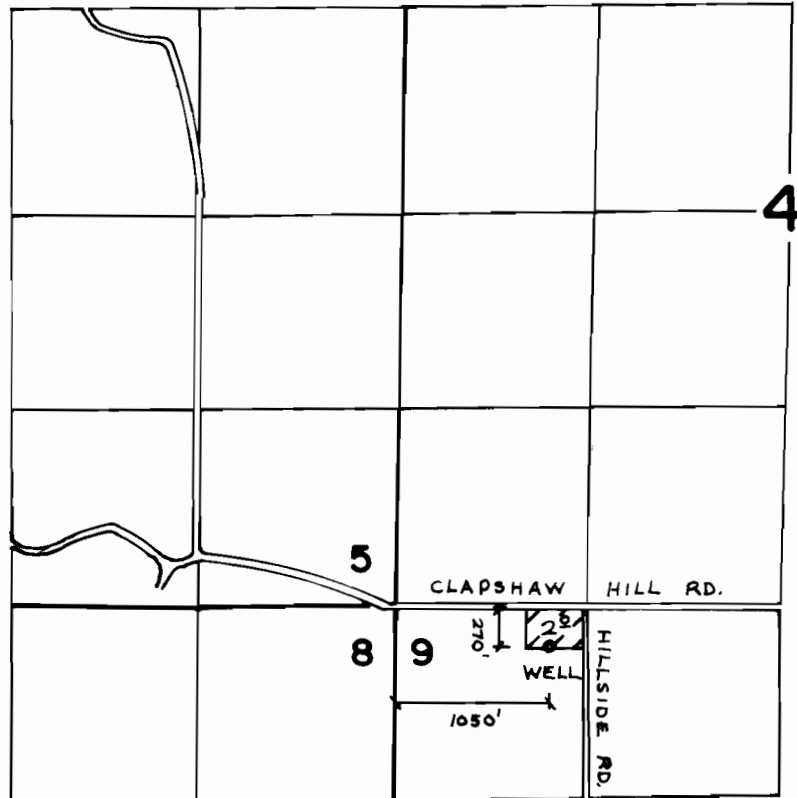

FINAL PROOF SURVEY
UNDER

Application No. **G-5914** Permit No. **G-5624**
IN NAME OF

HILLSIDE CEMETERY ASSOCIATION

Surveyed May 18 1976, by R.G. Mucken