


T. 1N. R. 4W. W.M.

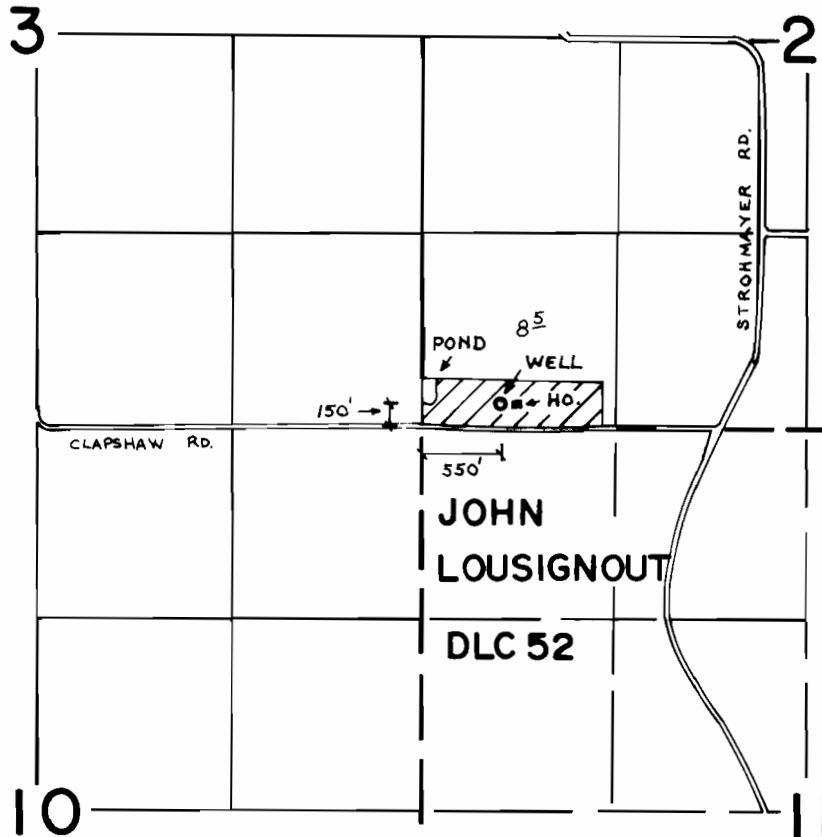

**FINAL PROOF SURVEY**  
UNDER

Application No. G-6205 Permit No. G-5261  
IN NAME OF

THOMAS C. GORDON

Surveyed May 18 1976, by R. G. Mucken