


T. 1 & 2 S. R. 4 W. W.M.

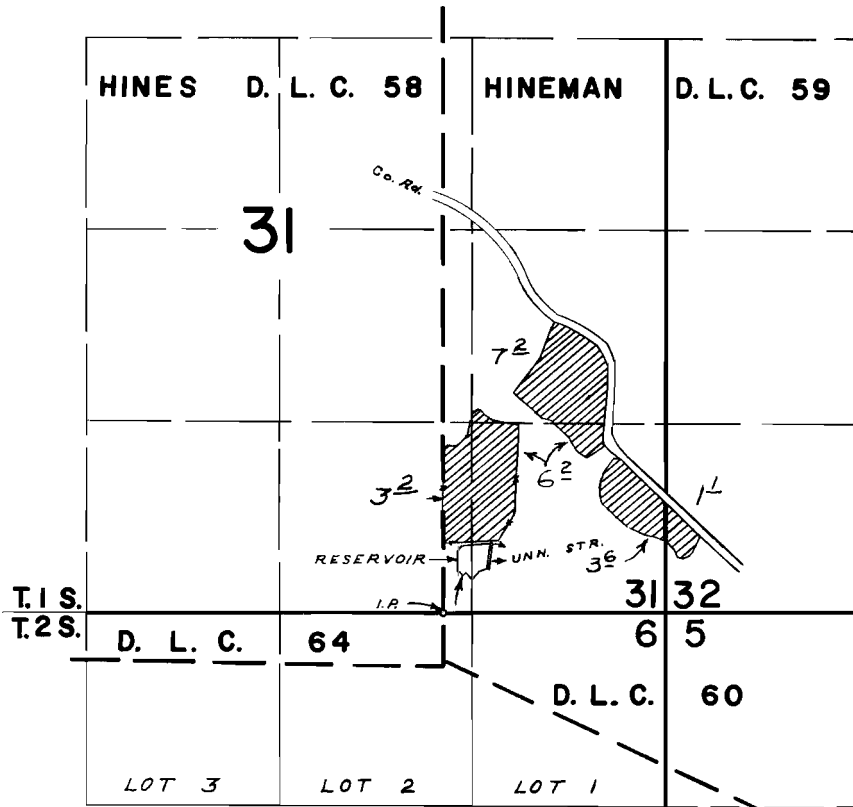

DIV. PT. LOCATED 350' N & 310' E FROM SW COR.
HINMAN D.L.C. # 59

FINAL PROOF SURVEY UNDER

R-40454 R-4519
Application No. 40455... Permit No. 30155...
IN NAME OF

JOHN MULHOLLAND

Surveyed OCT. 8, 1968, by W. J. RUPPERT