


T. 3 S., R. 4 W., W.M.

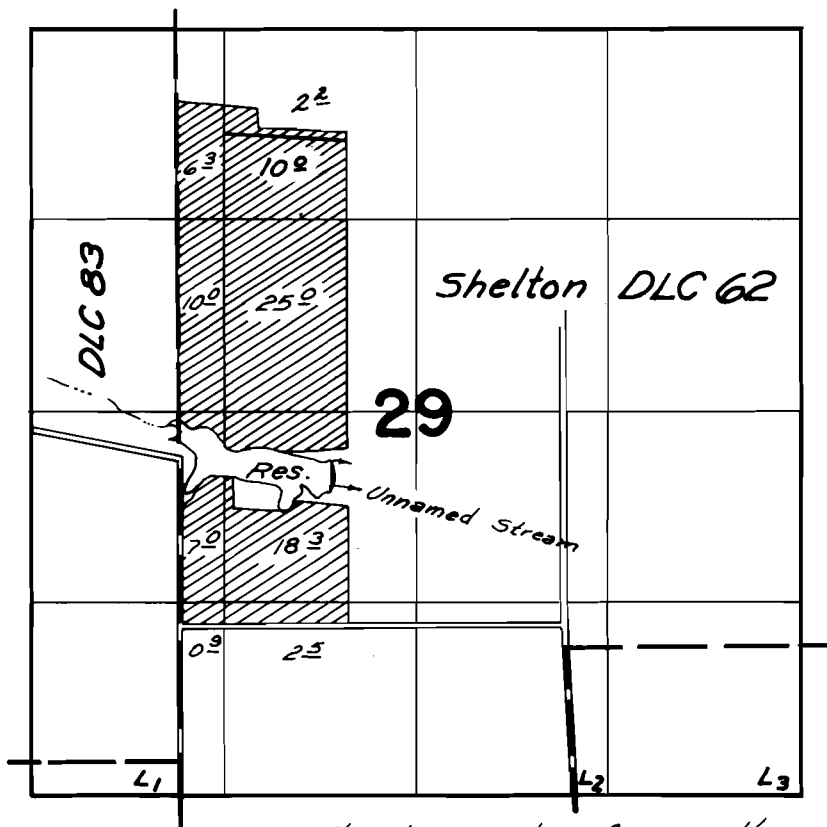

Div. Pt. Loc.: 500 A. S. & 2070 A. E. from W. 1/4
Cor. Sec. 29

FINAL PROOF SURVEY
UNDER

R-48338 R-5671
Application No. ~~48454~~ Permit No. ~~35339~~
IN NAME OF

Kenneth Martin

Surveyed Apr. 16., 1976, by L.H. Nunn