


T.2S., R.5W., W.M.

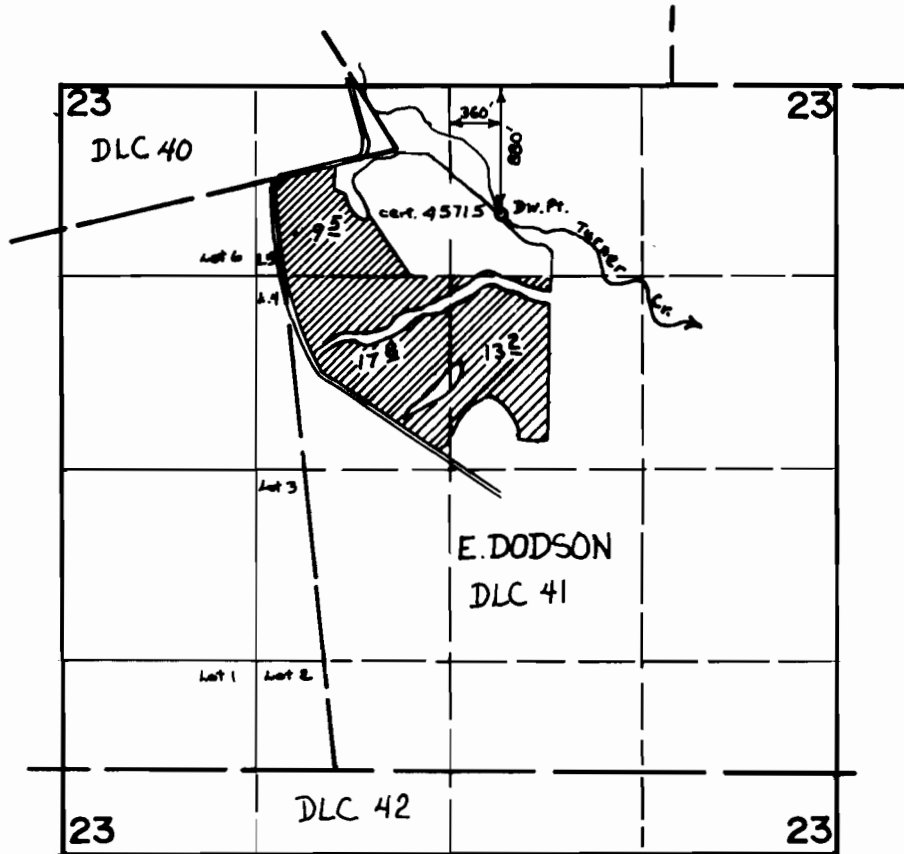

FINAL PROOF SURVEY
UNDER

Application No. 49205 Permit No. 36884
IN NAME OF

NELLIE M. MARTIN

Surveyed AUG. 6 1976, by L. H. NUNN