


T.2S., R.5W., W.M.

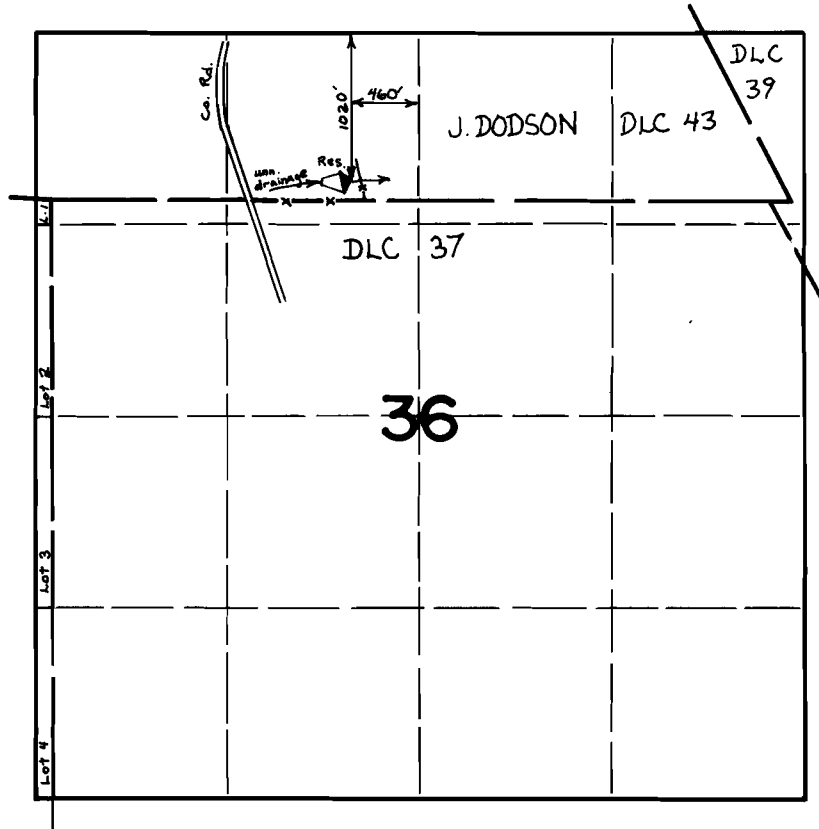

FINAL PROOF SURVEY UNDER

Application No. R-49448 Permit No. R-6016
IN NAME OF

DAVID SUTHERLAND

Surveyed JUNE 2, 1976, by L. H. NUNN