


T.5S., R.5W., W.M.

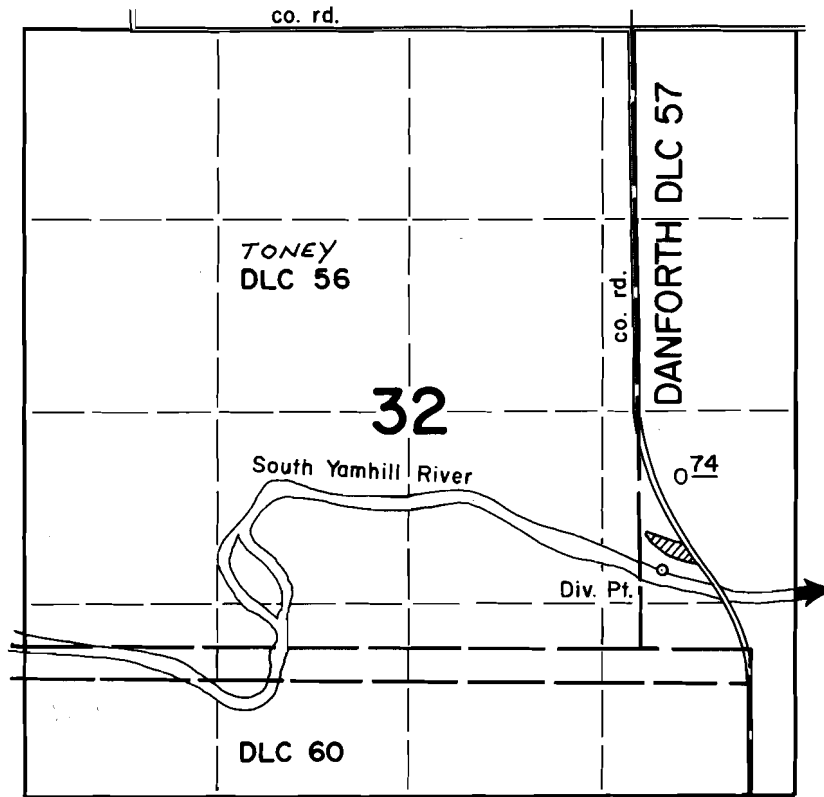

DIV. PT. LOC: 530' N & 150' E from S.E. COR. TONEY D.L.C. 56

FINAL PROOF SURVEY
UNDER

Application No. 50393 Permit No. 38034
IN NAME OF

COYE MORRIS

Surveyed July 7 1976, by L. H. Nunn