


T. 4 S., R. 4 W., W.M.

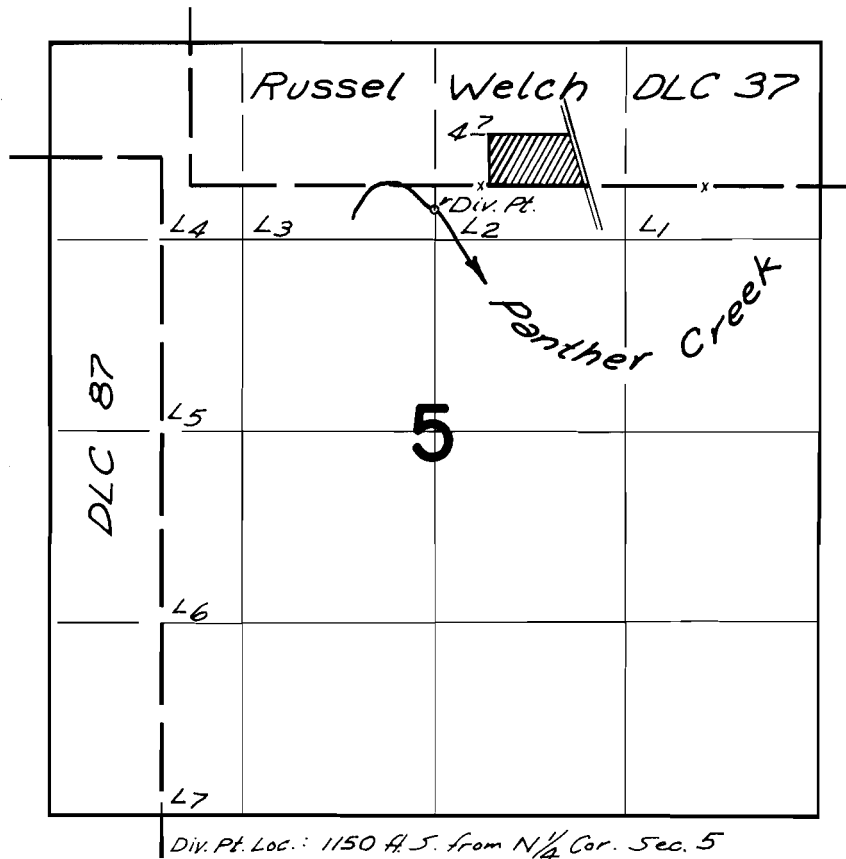

FINAL PROOF SURVEY UNDER

Application No. 50598 Permit No. 36955
IN NAME OF

Merle S. Dix

Surveyed June 4, 1976, by L. H. Nunn