


T.4S.,R.5W.,W.M.

**RECEIVED**  
MAY 22 1974  
STATE ENGINEER  
SALEM, OREGON

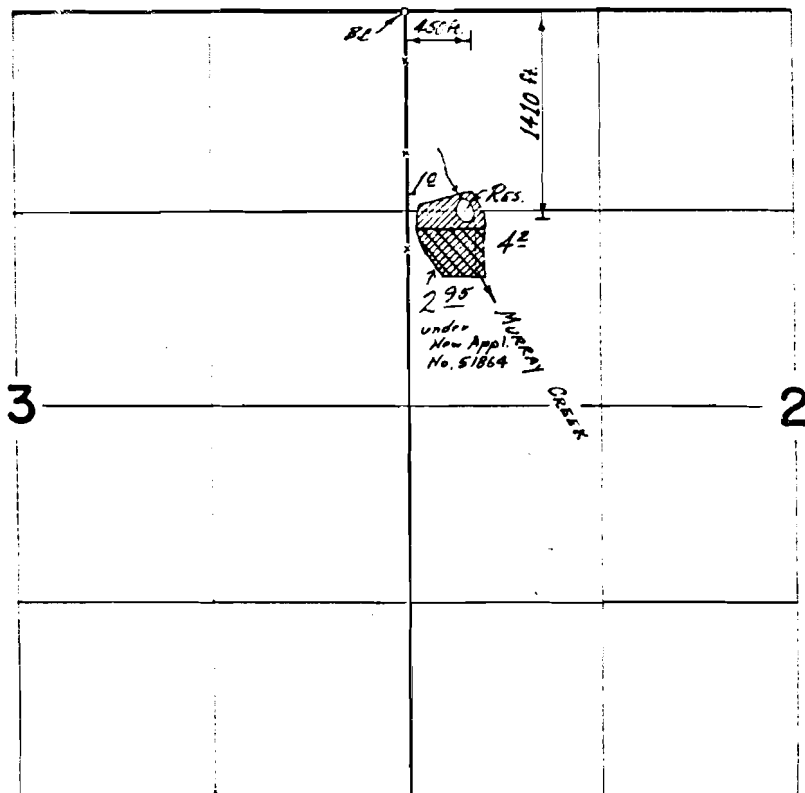

**FINAL PROOF SURVEY**  
UNDER

R-41910 R-4695  
Application No. 41911 Permit No. 31106  
IN NAME OF

..... DONALD R. MURRAY .....

Surveyed May 11, 1973, by D. NORBY.....

Application No. 51864  
Permit No. 39013