


T.3S., R.4W., W.M.

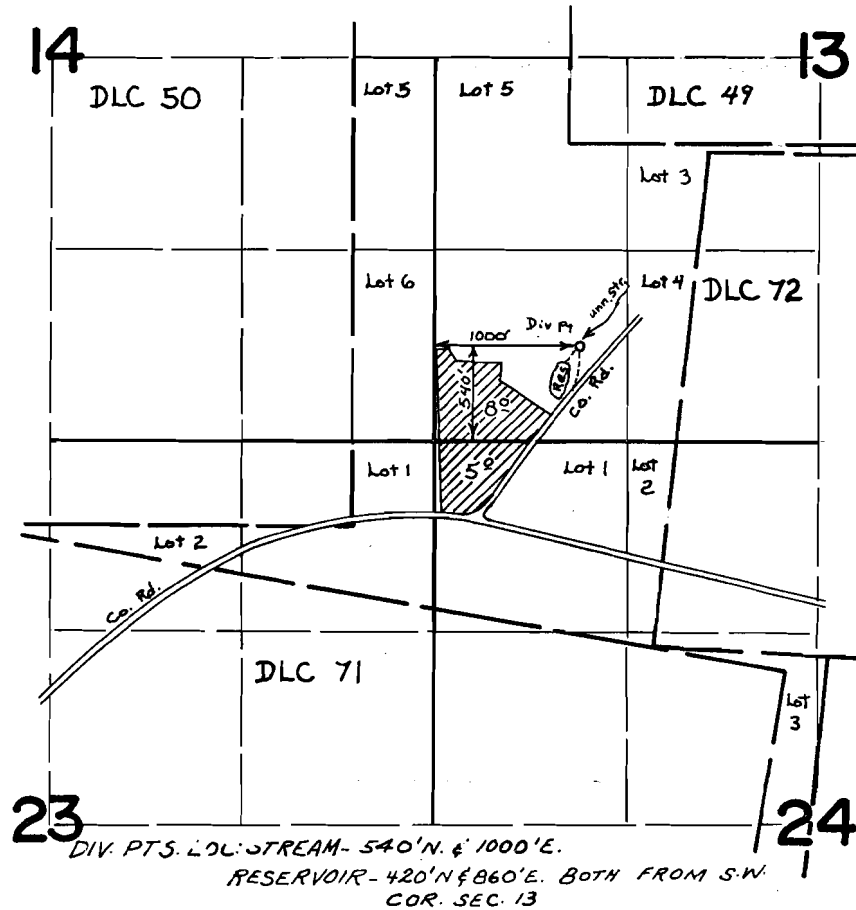

FINAL PROOF SURVEY
UNDER

R-52174 R-6089
Application No. 52175 Permit No. 37528
IN NAME OF
GEORGE STERMER

Surveyed APRIL 16 1976, by L. H. NUNN