


# T.3S., R.4W., W.M.

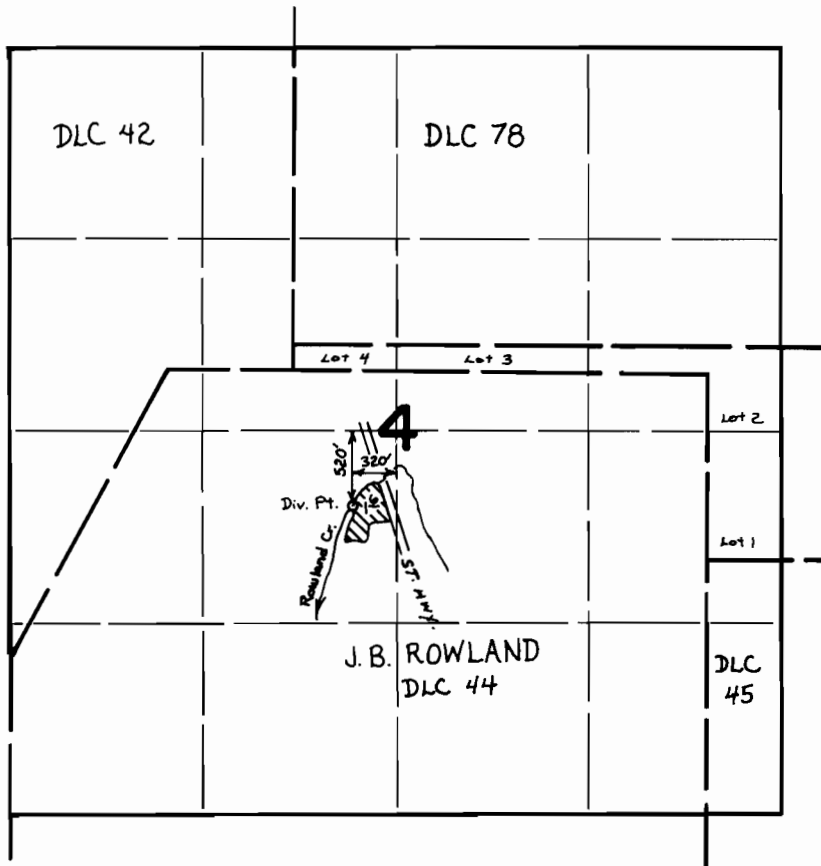

## FINAL PROOF SURVEY UNDER

Application No. 52392 Permit No. 37823  
IN NAME OF

DOUGLAS C. & SARA S. MILLER

Surveyed MARCH 30 1976, by L. H. NUNN