


T.2S., R.5W., W.M.

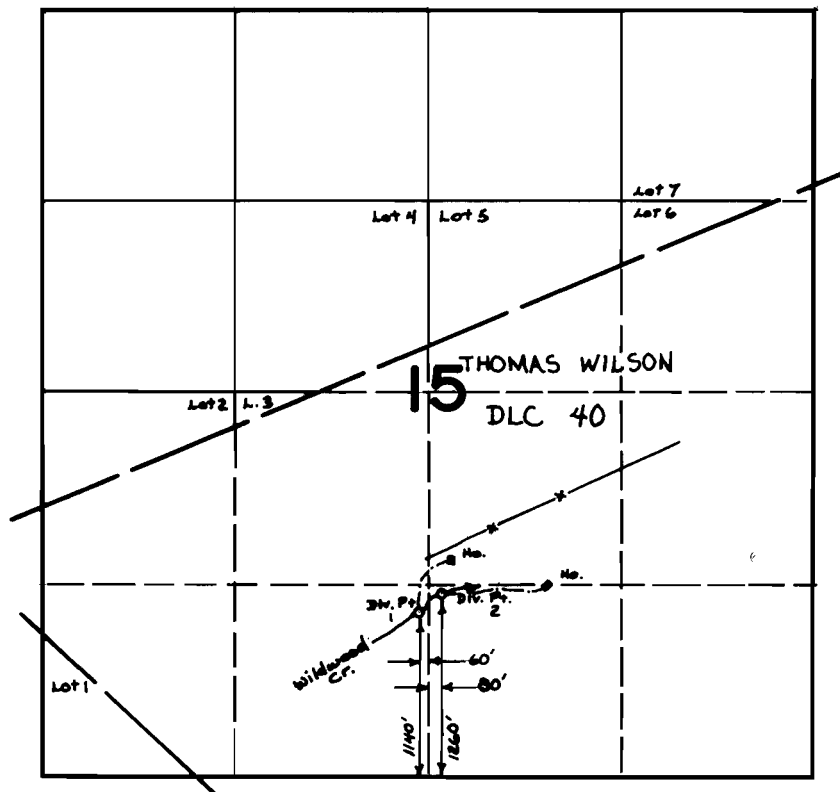

FINAL PROOF SURVEY UNDER

Application No. 52589 Permit No. 37725
IN NAME OF

DEE GOLDMAN

Surveyed JUNE 2 1976, by L. H. NUNN