


T.2S., R.4 $\frac{1}{2}$ W., W.M.

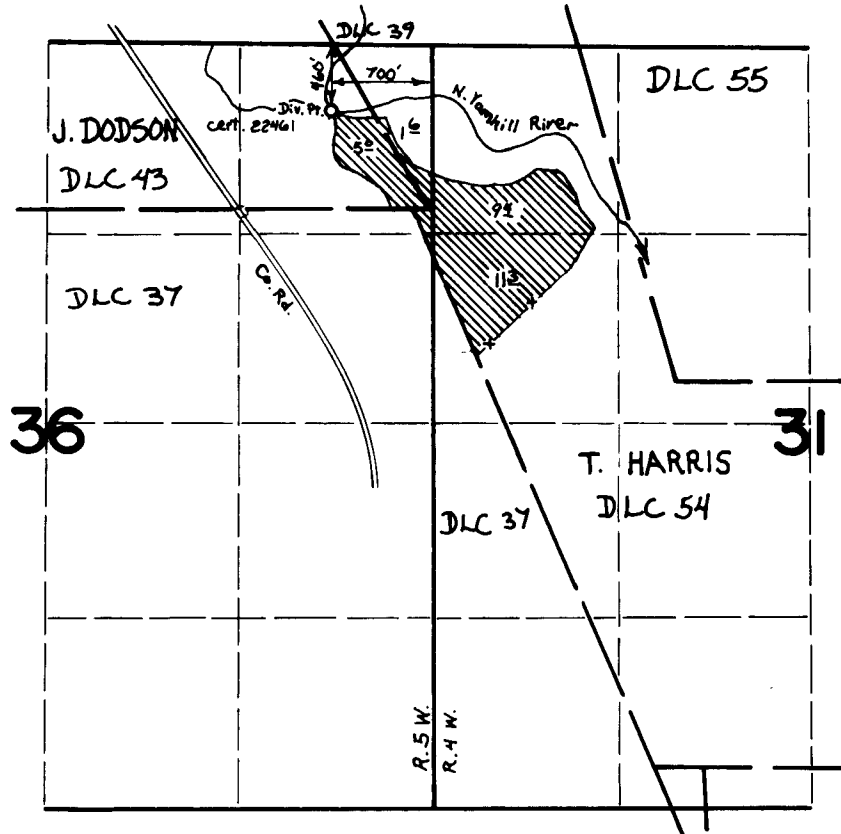

FINAL PROOF SURVEY UNDER

Application No. 52848 Permit No. 39891
IN NAME OF

HARLEY S. BELT

Surveyed AUG. 3 1976, by L. NUNN