


T.4 S., R.7 W., W.M.

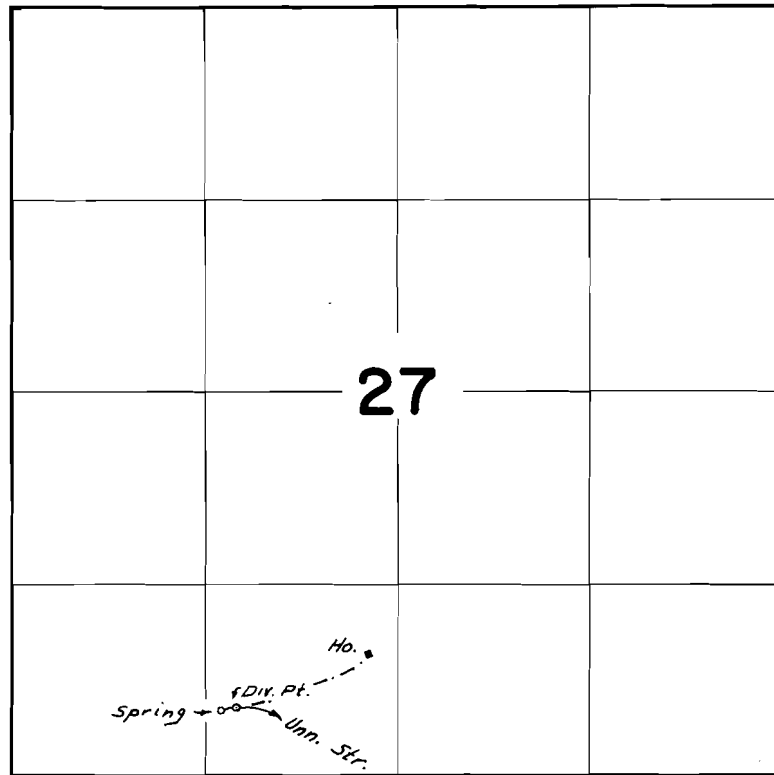

Div. Pt. Loc.: 470 H. N. & 1110 H. W. from $5\frac{1}{4}$ Cor. Sec. 27

FINAL PROOF SURVEY
UNDER

Application No. 53105 Permit No. 38587
IN NAME OF

Emery & Helen Tegelberg

Surveyed May 14, 1976 by L. H. Nunn

DFG-3LL-64 *NB*