


T.3S.,R.3W.,W.M.

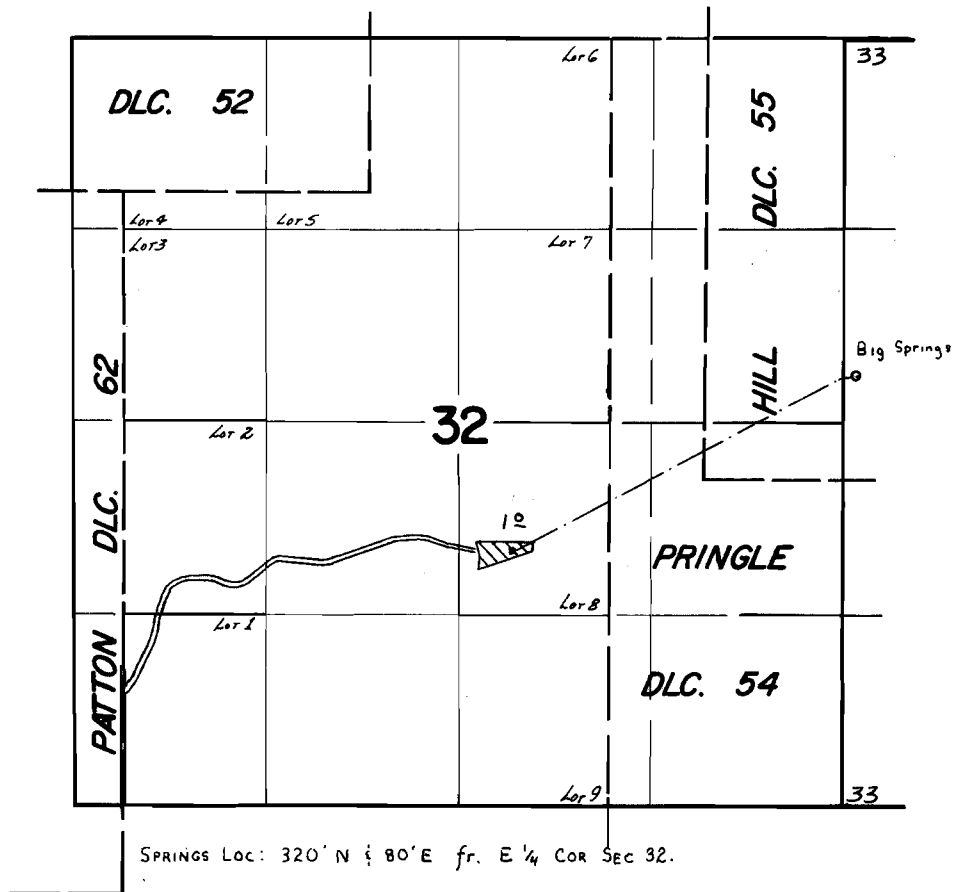

**FINAL PROOF SURVEY**  
UNDER

Application No. 48485 Permit No. 36066  
IN NAME OF

DALE B. SMITH

Surveyed SEPT. 17, 1973, by L. E. GOULD