


T. 10 S. R. 4 W. W.M.

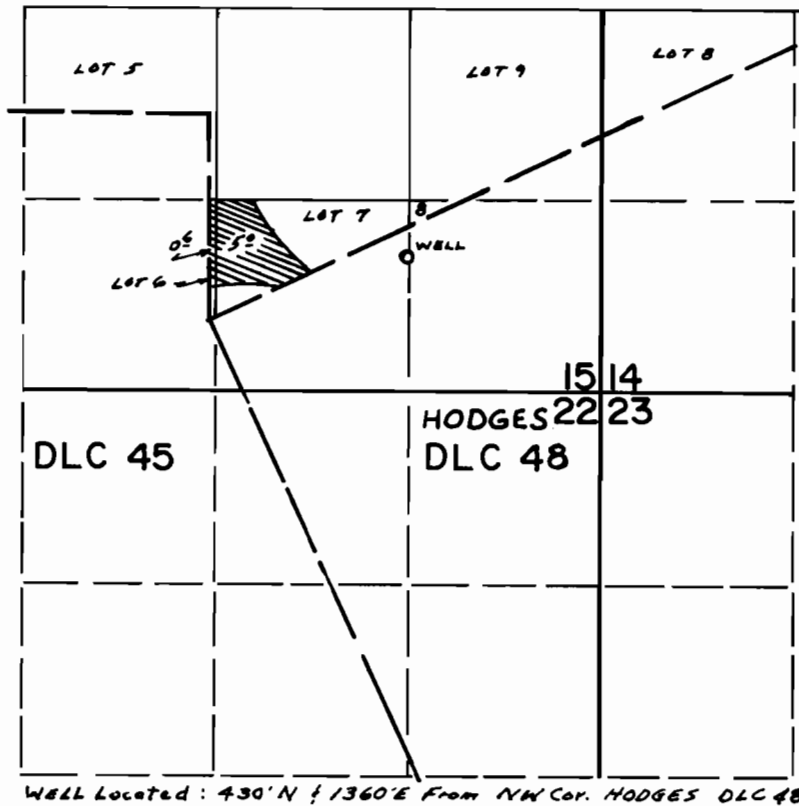

FINAL PROOF SURVEY UNDER

Application No. ~~G-7375~~ Permit No. ~~G-6822~~
IN NAME OF

.....RUSSELL UNDERWOOD.....

Surveyed ~~9-12~~ 1977, by R. BARWIN.....