


T.12 S. R. 6 W. W.M.

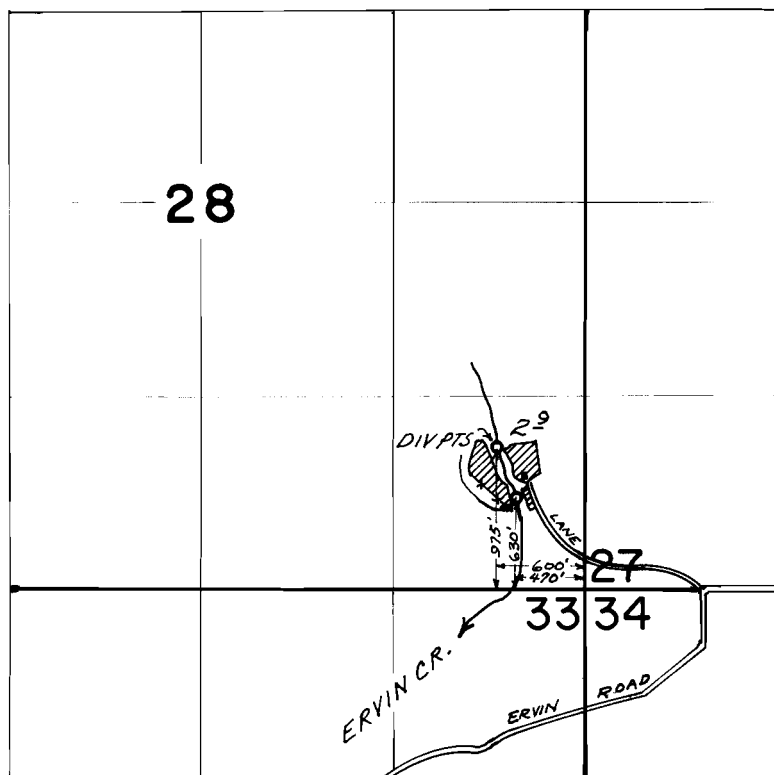

FINAL PROOF SURVEY
UNDER

Application No. 44649 Permit No. 33284
IN NAME OF
GEORGE C. & BERTHA M. BELIEU
Surveyed SEP. 10. 1976. by D. BUELL