


# T.12S.,R.6W.,W.M.

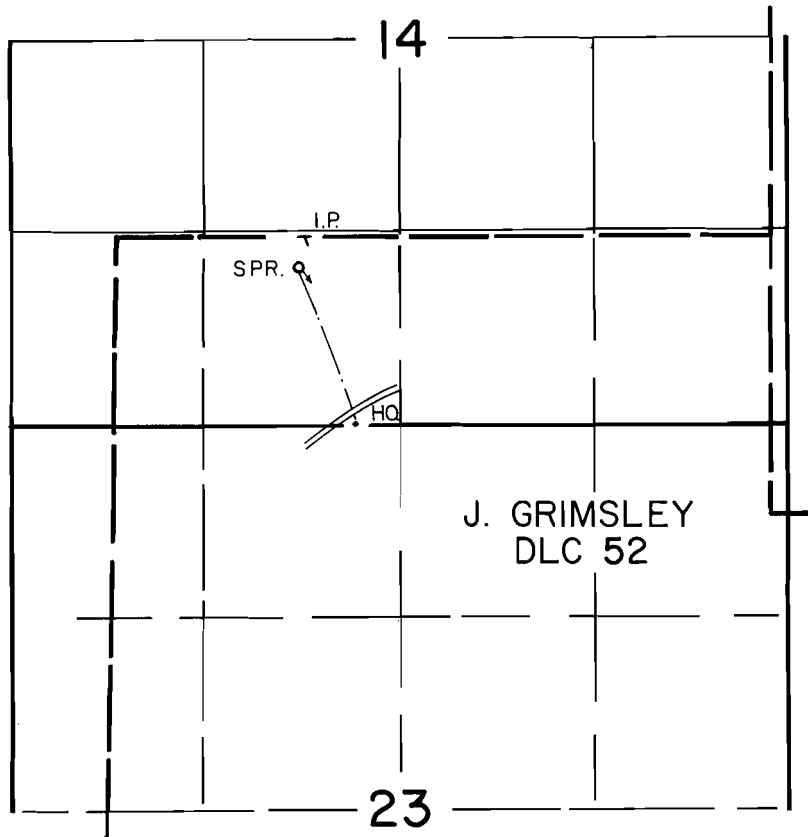

SPRING LOC.: 210' S. & 1250' E. FROM NW. COR. DLC 52

## FINAL PROOF SURVEY UNDER

Application No. 54486 Permit No. 40865  
IN NAME OF

JOHN V. & RUTH R. BATEMAN

Surveyed AUG. 17, 1977, by R. BARWIN