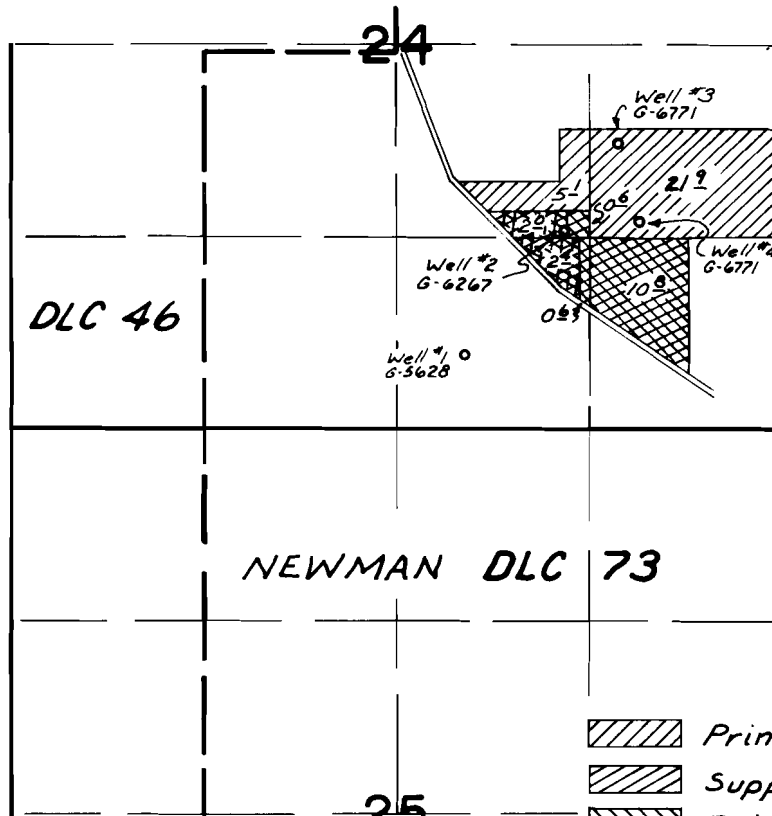
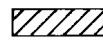

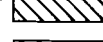
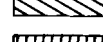
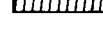


T. 5S., R. 1W., W.M.



Wells Loc.: #1-520' N. & 2170' W.; #2-1360' N. & 1480' W.; #3-1960' N. & 1120' W.; #4-1430' N. & 980' W.; all from SE Cor. Sec. 24

-  Primary G-6771
-  Supp'l G-6771
-  Primary G-6267
-  Supp'l G-6267
-  Primary G-5628

FINAL PROOF SURVEY UNDER

Application No. G-5628 Permit No. G-5461
G-6267 G-5902
G-6771 G-6289

IN NAME OF

Van Veen Nurseries

Surveyed July 28, 1977, by AC Brown