


# T. 5S., R. 1W., W.M.

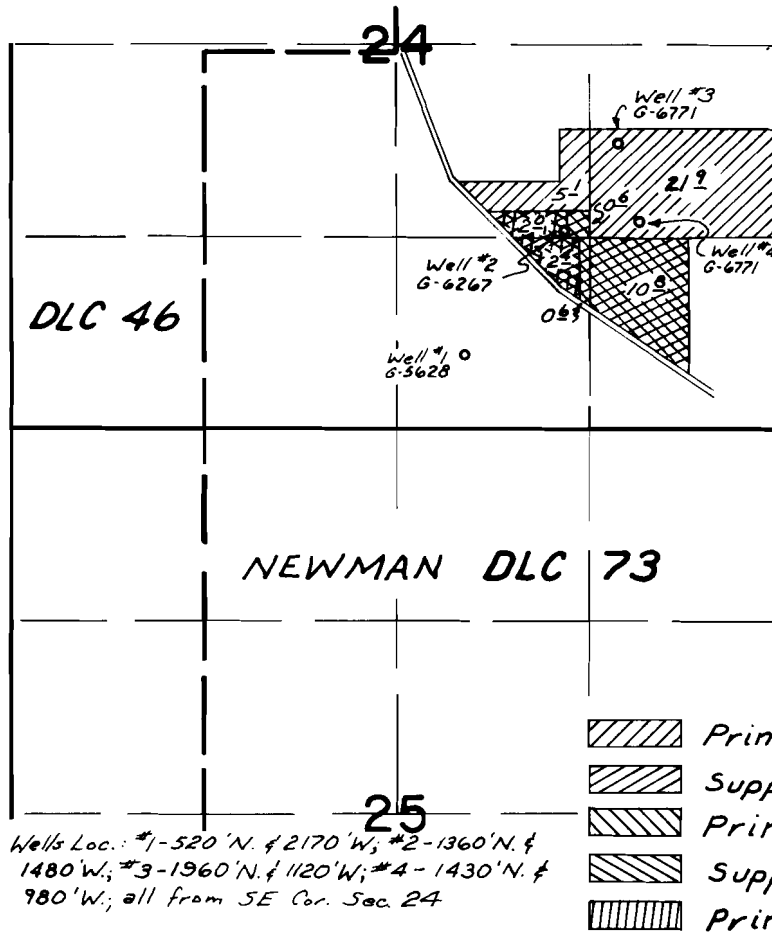

## FINAL PROOF SURVEY UNDER

Application No. G-5628 G-5461  
G-6267 G-5902  
G-6771 Permit No. G-6289

IN NAME OF

*Van Veen Nurseries*

Surveyed July 28, 1977, by AC Brown