


T.6S.,R.2E.,W.M.

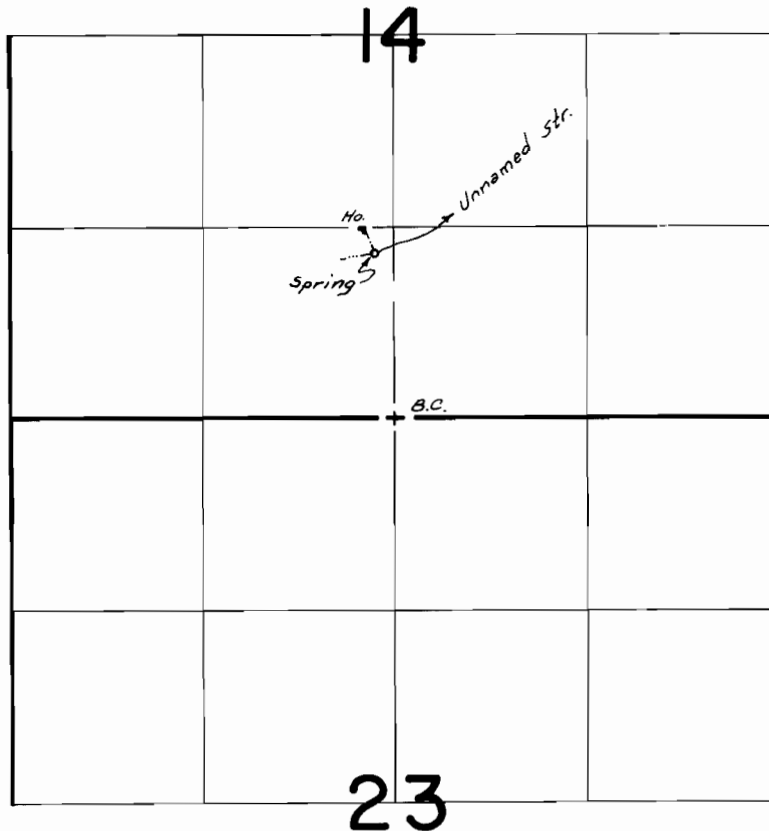

Spring Loc.: 1130' N. & 130' W. from $\frac{5}{4}$ Cor. Sec 14

FINAL PROOF SURVEY
UNDER

Application No. 54242 Permit No. 40628
IN NAME OF

Mary Hay Dugan

Surveyed July 29, 1977 by J.C. Brown