
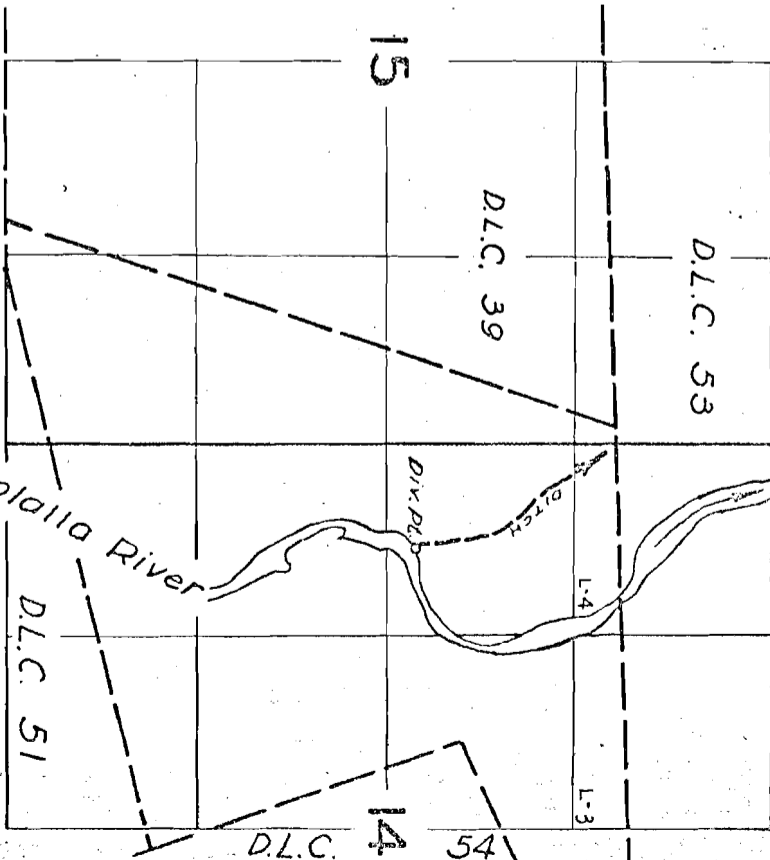


T.4S. R.2E.W.M.

T.5S. R.2E.W.M.

RR
4-7-159

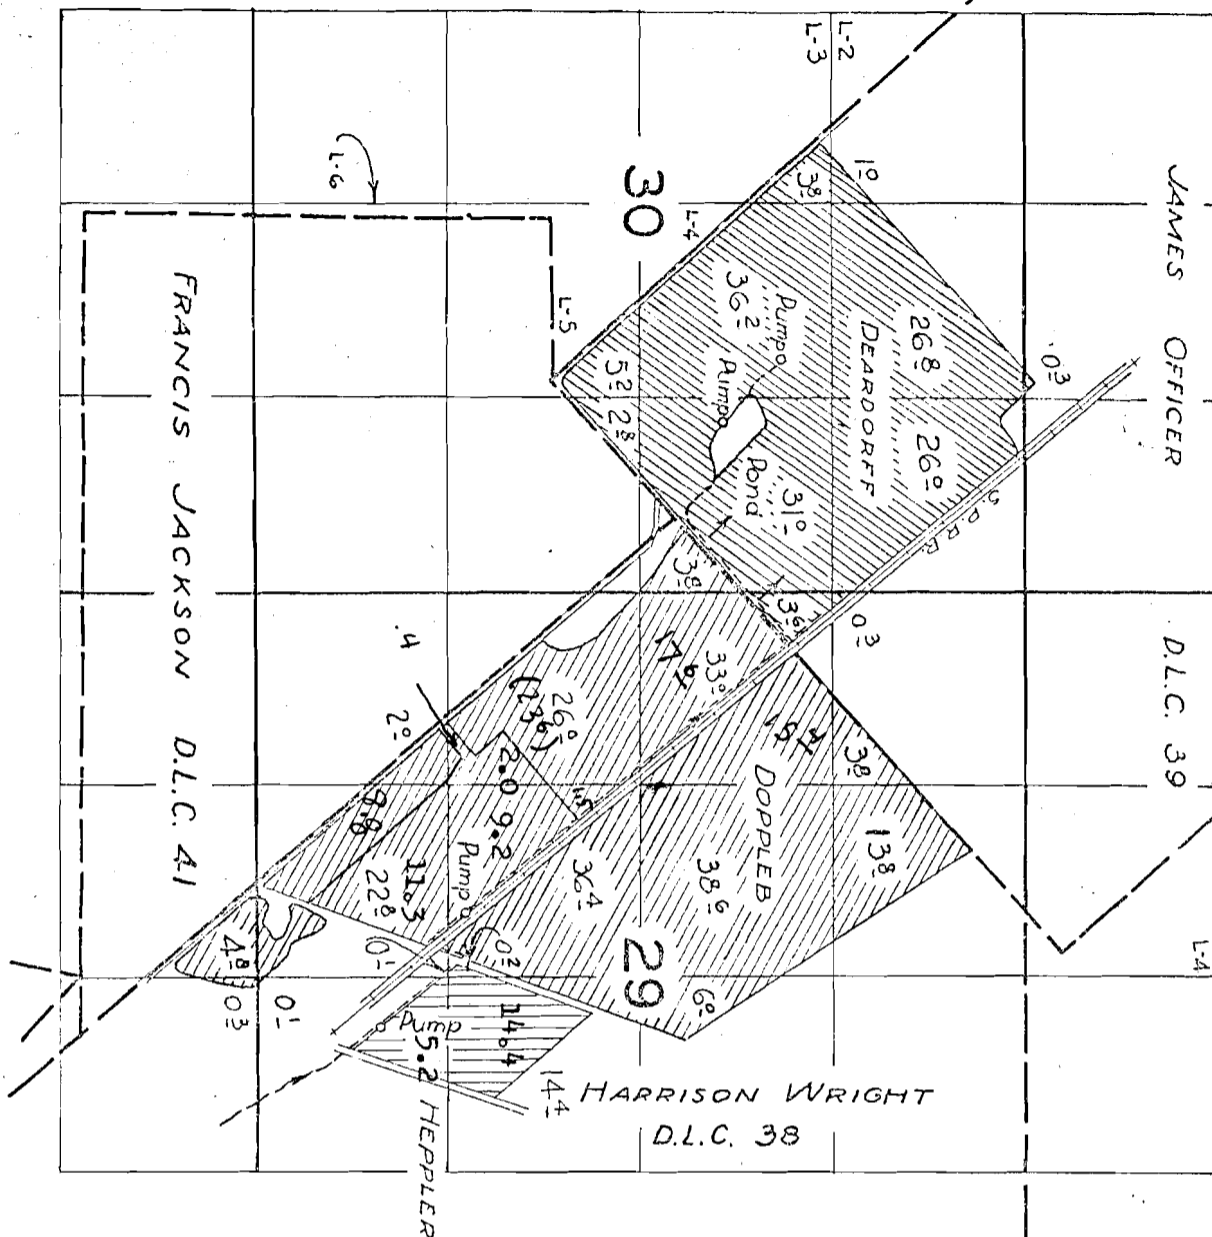

FINAL PROOF SURVEY
UNDER
APPLICATION NO. 10652 PERMIT NO. 7852
IN NAME OF
W.G. DEARDORFF - V.C. DOPPLEB
SURVEYED JUNE 16, 1958 BY C.O. BARTELS