


T.6N.,R.8W.,W.M.

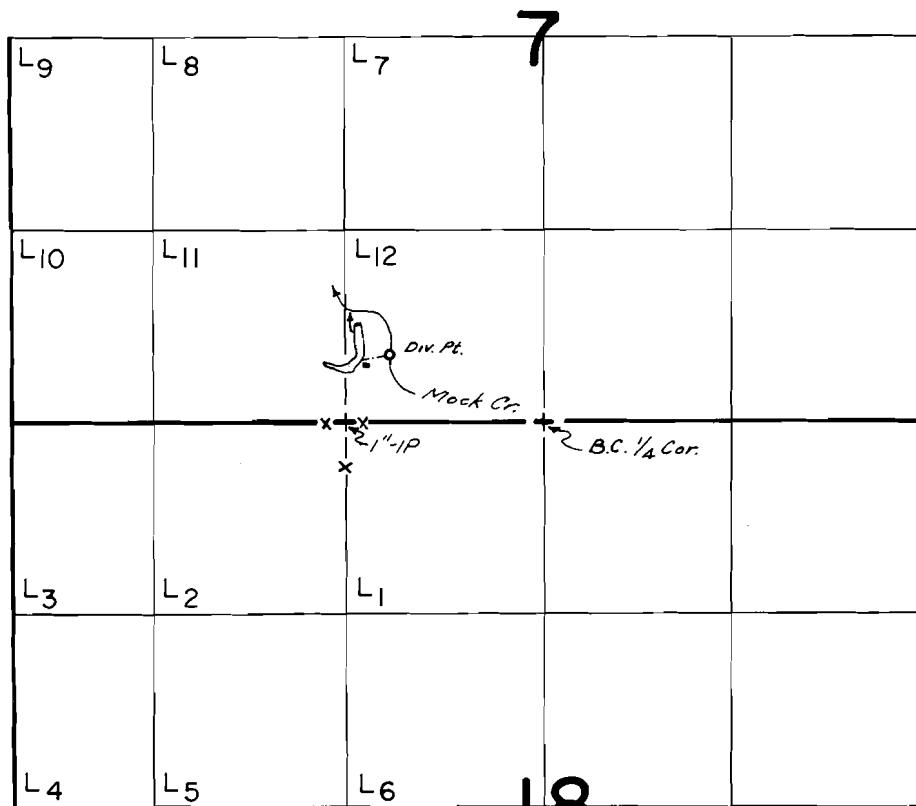

Div. Pts. Loc.: Creek - 460' N. of 300' E.; Res. - 670' N. of 80' E.; both from SW Cor. Lot 12

FINAL PROOF SURVEY UNDER

R-52890 R-6420
Application No. 52891 Permit No. 40295
IN NAME OF

Christine K. (Mock) Mikesch

Surveyed Aug 31, 1977, by d. Brown