


T.5N., R.9W., W.M.

SCALE 1" = 330'

2.C. 1/4 COR.

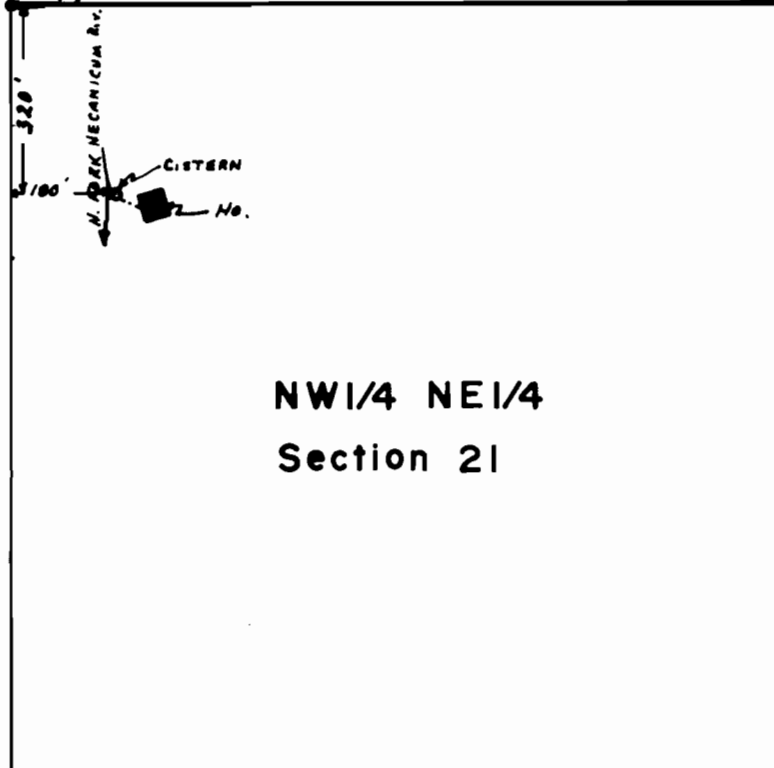

FINAL PROOF SURVEY
UNDER

Application No. 54911 Permit No. 40906.
IN NAME OF

STANLEY G. JOHNSON

Surveyed Sept. 29 1977, by S.C. BROWN