


T6N. R.5W. W.M.

SEC. 18

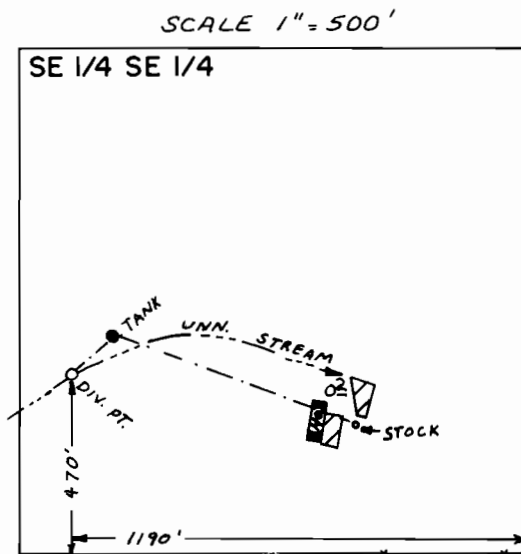

FINAL PROOF SURVEY
UNDER

Application No. 44728... Permit No. 33510.....
IN NAME OF

.....HOWARD G. JONES.....

Surveyed JUNE 9, 1976, by L.H. NUNN.....