


T.7N. R.4W. W.M.

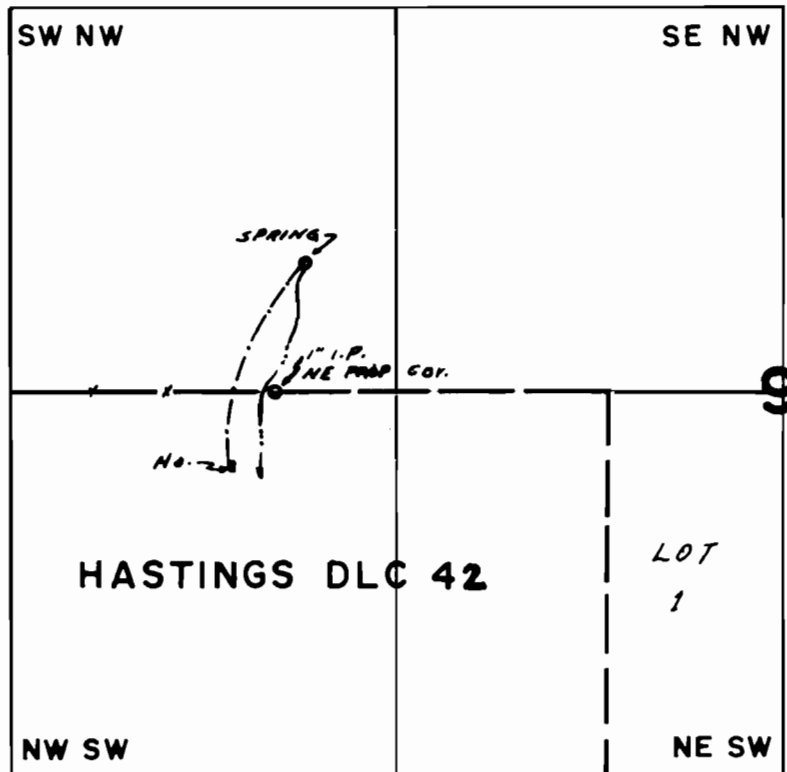

SPRING LOC. - 140' N, 1000' E FROM W 1/4 COR. SEC. 9

SCALE = 1" = 660'

FINAL PROOF SURVEY
UNDER

Application No. 49199 Permit No. 36880
IN NAME OF

GENE W. & ELVA M. GROSKOPF

Surveyed 8-24 1977, by S.C. BROWN