


P- 34344
47169

T.10S. R.26E. W.M.

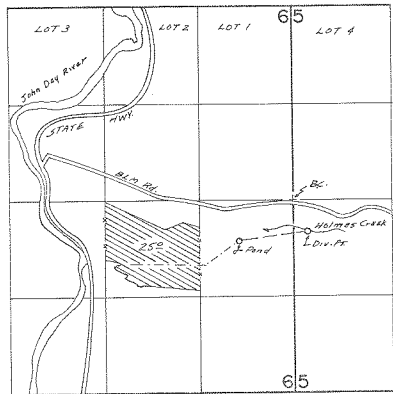

Div. Pt. Loc. 420'S / 200'E From W 1/4 Cor. Sec. 5

FINAL PROOF SURVEY UNDER

Application No. 45977... Permit No. 34344
IN NAME OF

CARL R. SLAUGHTER

Surveyed Sept. 21, 1977, by S.C. BROWN

DDU-3FF-230-11