


T.40S.R.35E.W.M.

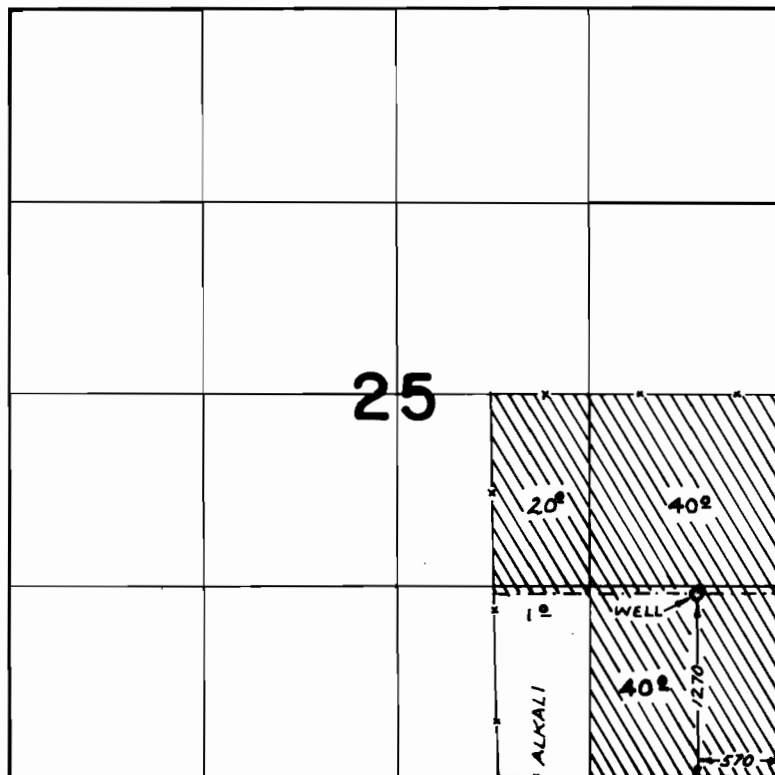

FINAL PROOF SURVEY
UNDER

Application No. G-4786 Permit No. G-4704
IN NAME OF

WALTER WALDKIRCH

Surveyed JUNE 17, 1976, by R. MUCKEN