


# T.35S., R.4W., W.M.

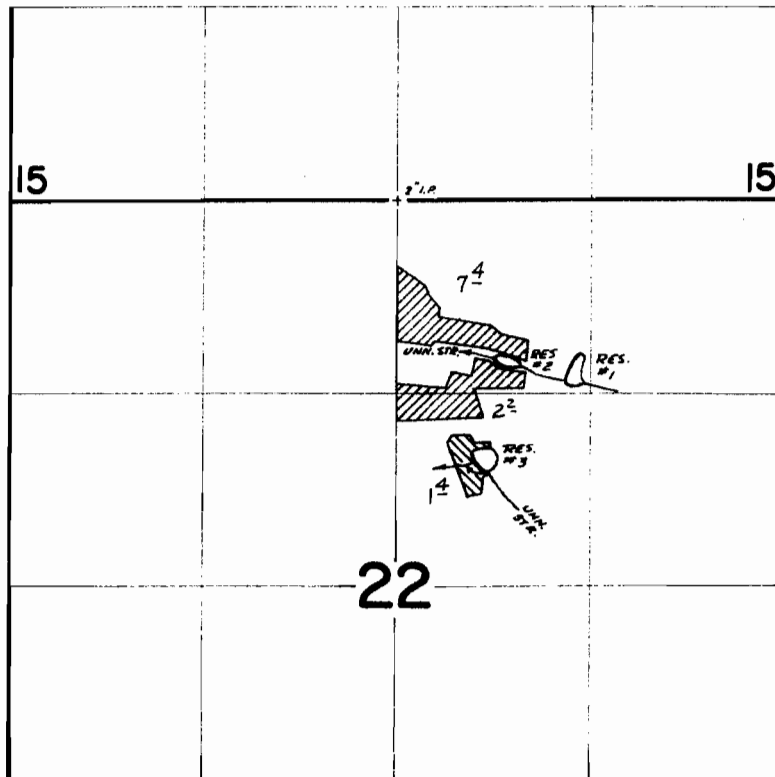

RES. LOC: 1- 1240'S & 1150'E; 2- 1080'S & 660'E; 3- 1790'S & 530'E  
 ALL FROM N 1/4 COR. SEC. 22

 RES. 1 & 2  
 RES. 3

## FINAL PROOF SURVEY UNDER

Application No. R-47183 47134 Permit No. R-5676 35349

IN NAME OF  
CLYDE E. AND IONA A. FARLOW AND  
JAMES L. AND/OR PATRICIA HALEY

Surveyed May 7 1975, by D. Norby