


T.18S. R.7W. W.M.

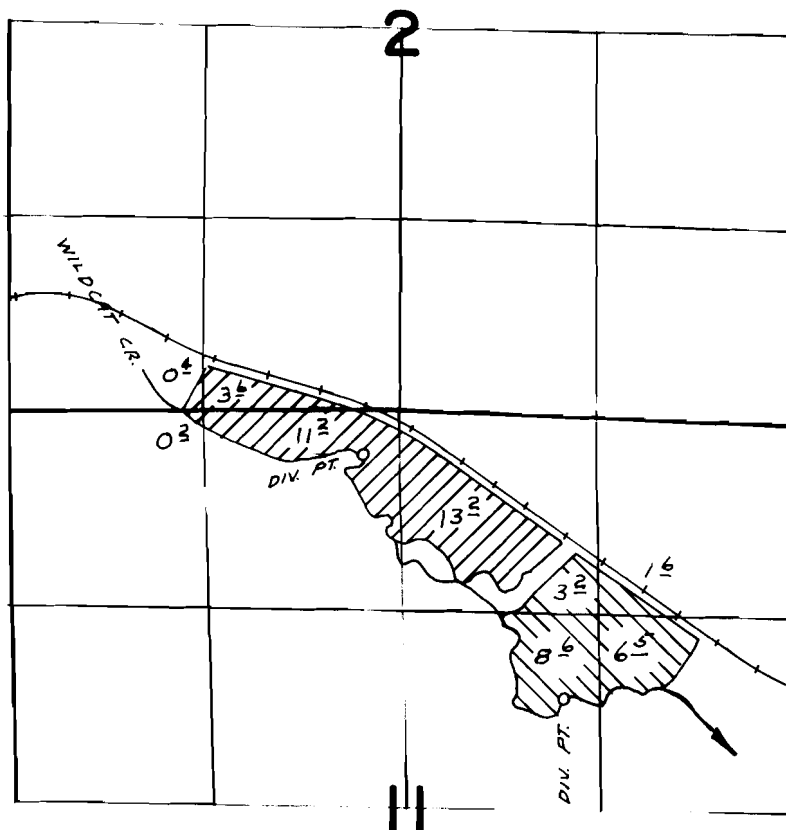

PERMIT 34352 DIV. PT. LOC. 1970' S. & 1140' E. FROM
N 1/4 COR., SEC. 11. PERMIT 37993 DIV. PT. LOC. 300' S.
& 250' W FROM N 1/4 COR. SEC. 11.

FINAL PROOF SURVEY
UNDER

45991 34352
Application No. 53143 Permit No. 37933
IN NAME OF

LAWRENCE WARDEN

Surveyed MAY 6 1976, by L.H. NUNN