


T.17S., R.8W., W.M.

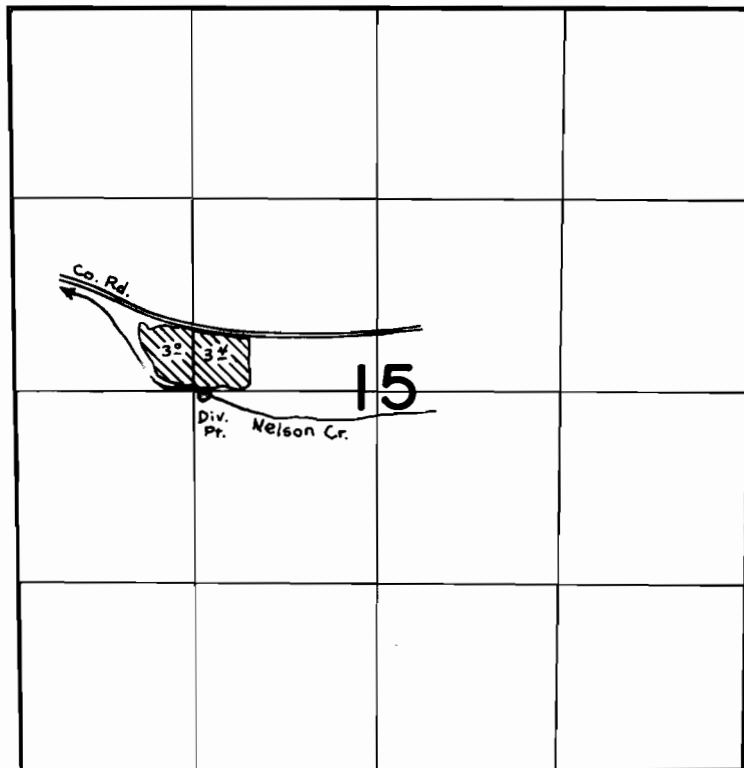

Div. Pt. Located: 20' S & 1180' W from the C/4 corner Sec. 15

FINAL PROOF SURVEY
UNDER

Application No. 46885 Permit No. 35054
IN NAME OF

JOHN P. PIGNONE

Surveyed MAY 18 1976, by D. NORBY