


T. 6 S., R. 10 W., W. M.

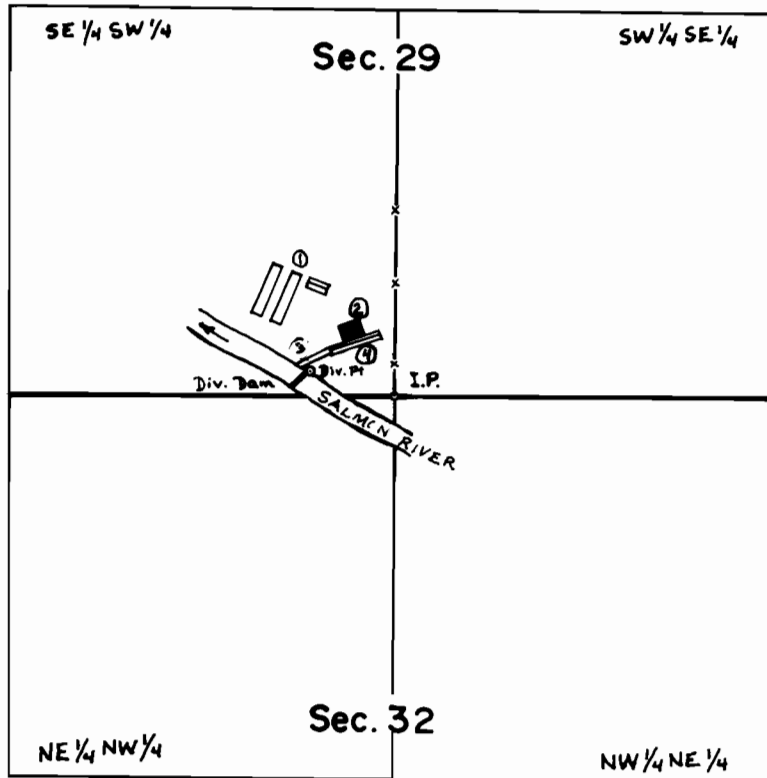

Div. Pt. Located: 75' N & 290' W from S 1/4 cor. Sec. 29

SCALE: 1" = 660'

FINAL PROOF SURVEY UNDER

Application No. 52320 Permit No. 37769
IN NAME OF

OREGON DEPARTMENT OF FISH & WILDLIFE

Surveyed OCT. 27, 1977, by J.S. DONALDSON