


T.I.S., R.I.W., W.M.

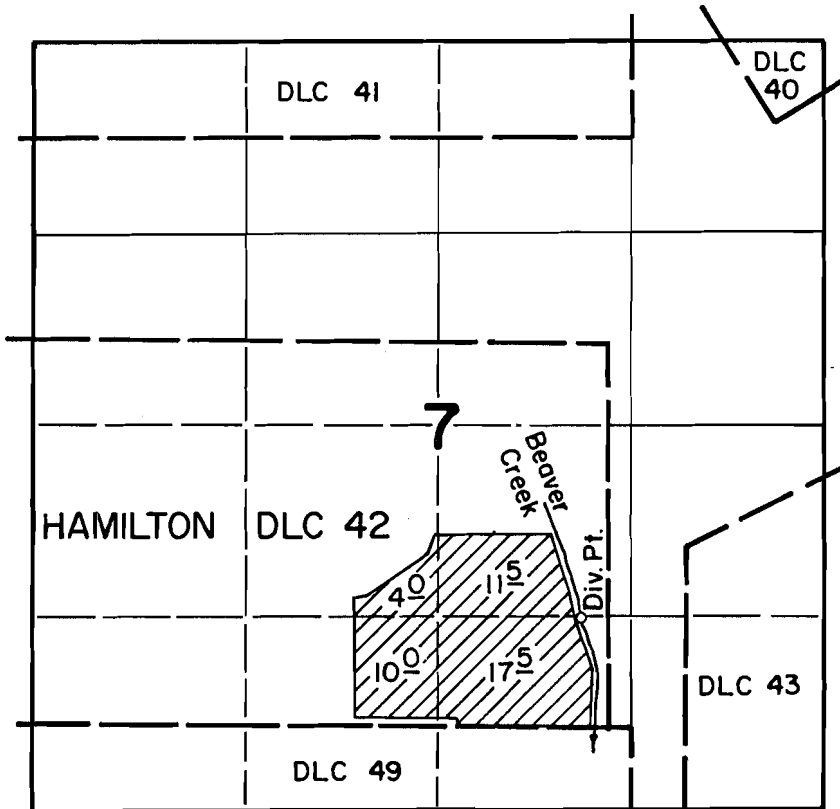

DIV. PT. LOC: 760' N & 180' W from SE cor. Hamilton DLC 42

FINAL PROOF SURVEY UNDER

Application No. 53755 Permit No. 39928
IN NAME OF

VICTOR E. & JERRY V. HANSON

Surveyed Oct. 20 1976, by D. Norby