


T.13S. R.1E.2E. W.M.

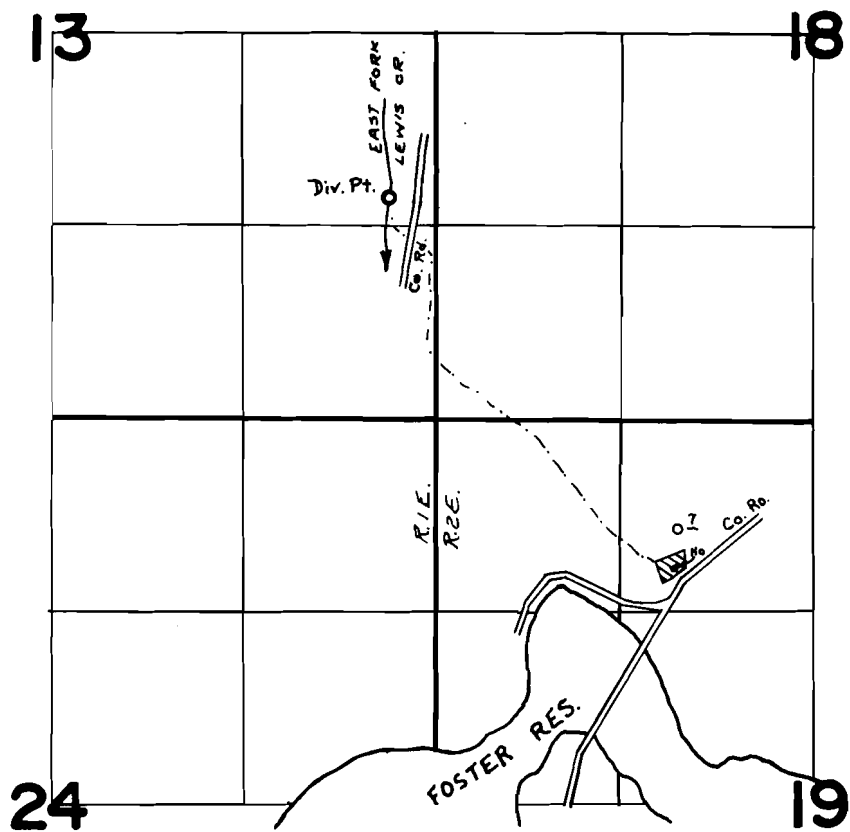

Div. Pt. Located: 1520' N of 320' W from SE cor Sec. 13

FINAL PROOF SURVEY UNDER

Application No. 54162 Permit No. 40547
IN NAME OF

LLOYD NIXON

Surveyed NOV. 9 1977, by J.S. DONALDSON