


T.6S.,R.2W.,W.M.

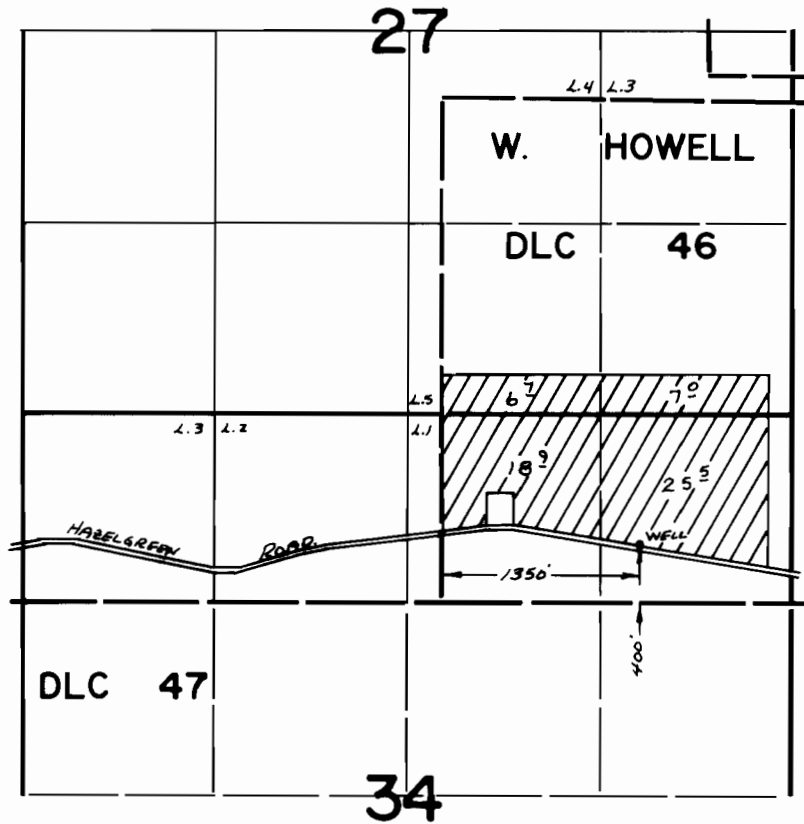

**FINAL PROOF SURVEY**  
UNDER

Application No. G-5908 Permit No. G-5620  
IN NAME OF

JOE J. DITCHEN

Surveyed MAY 7 1976, by L. T. GLENN