


T.5S.,R.1W.,W.M.

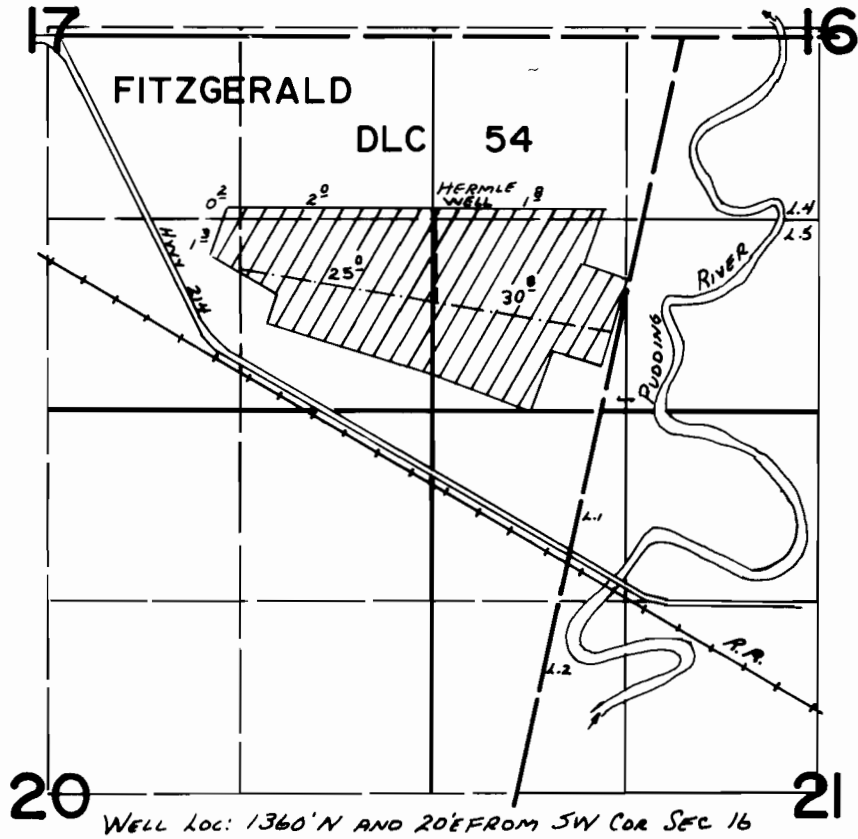

FINAL PROOF SURVEY
UNDER

Application No. G-6044 Permit No. G-5720.
IN NAME OF

..... PAUL J. SERRES

Surveyed APRIL 22, 1976, by L. Toll